


T. 7 S. R. 4 W. W. M.

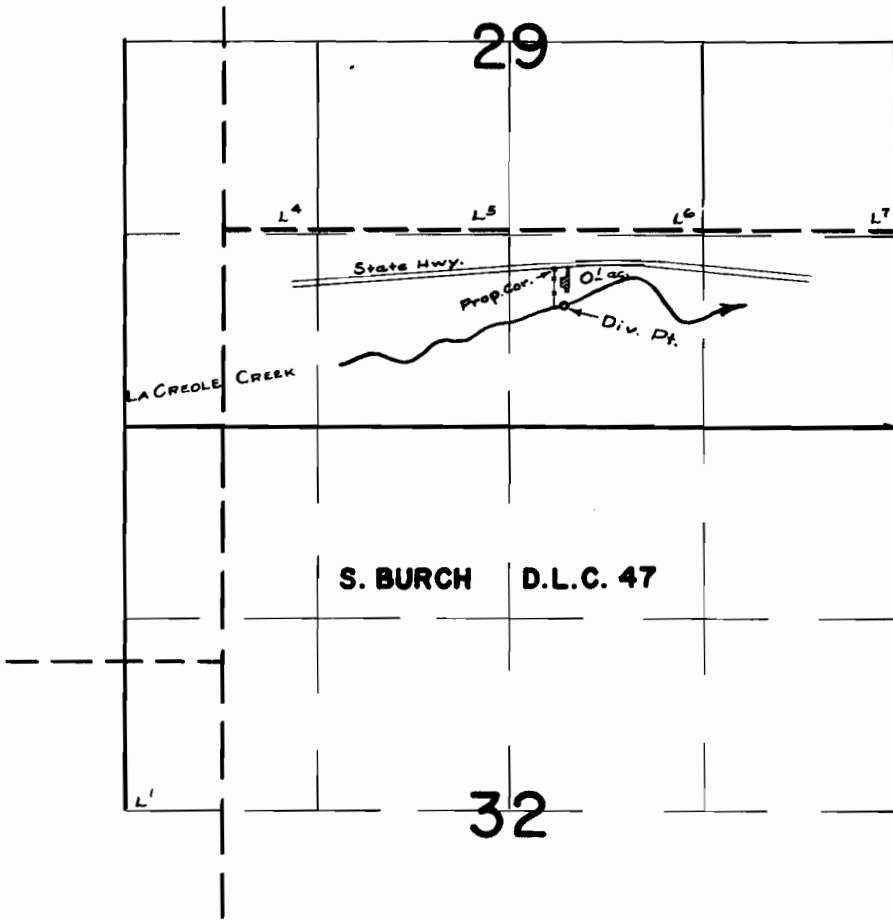

**FINAL PROOF SURVEY**  
UNDER

Application No. 31409 Permit No. 24835  
IN NAME OF

DOROTHY ELAINE SANDERSON

Surveyed JULY 27 1961, by Tom Bish