


T.6 S.R.3 W.W.M.

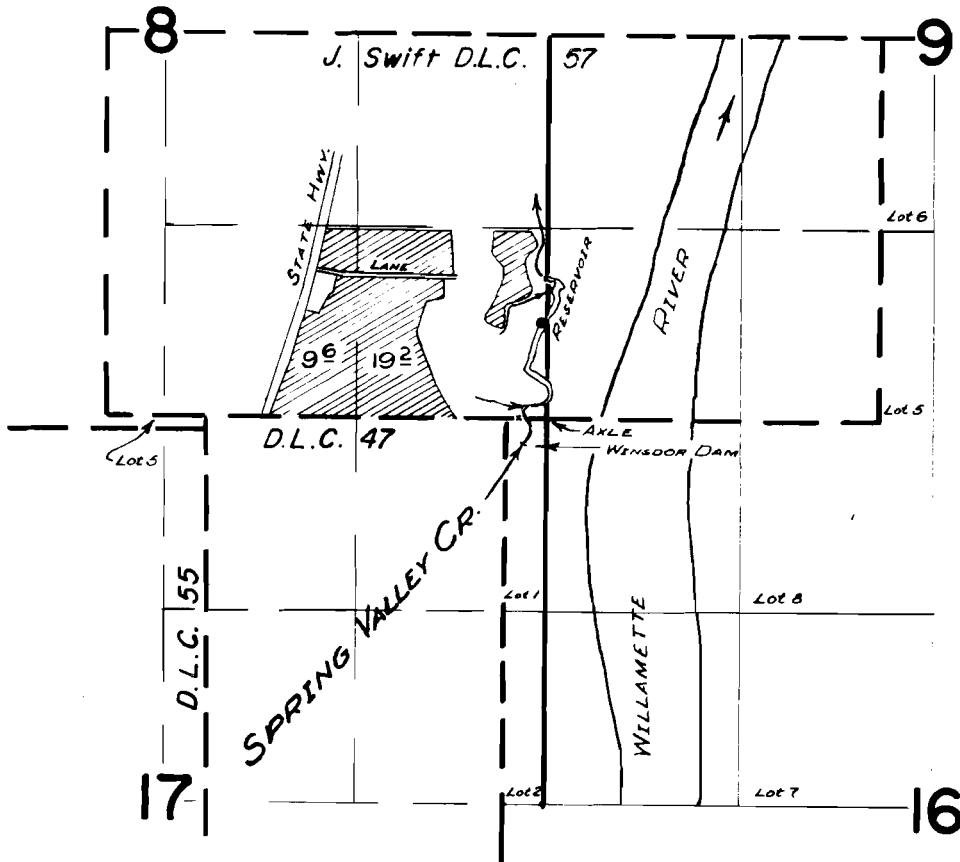

FINAL PROOF SURVEY UNDER

R-31705 R-2041
Application No. 31706 Permit No. 24999
IN NAME OF

THEODORE DAUM

Surveyed 21 MAR. 1961, by *m. Bish*