


T. 6 S. R. 6 W. W. M.

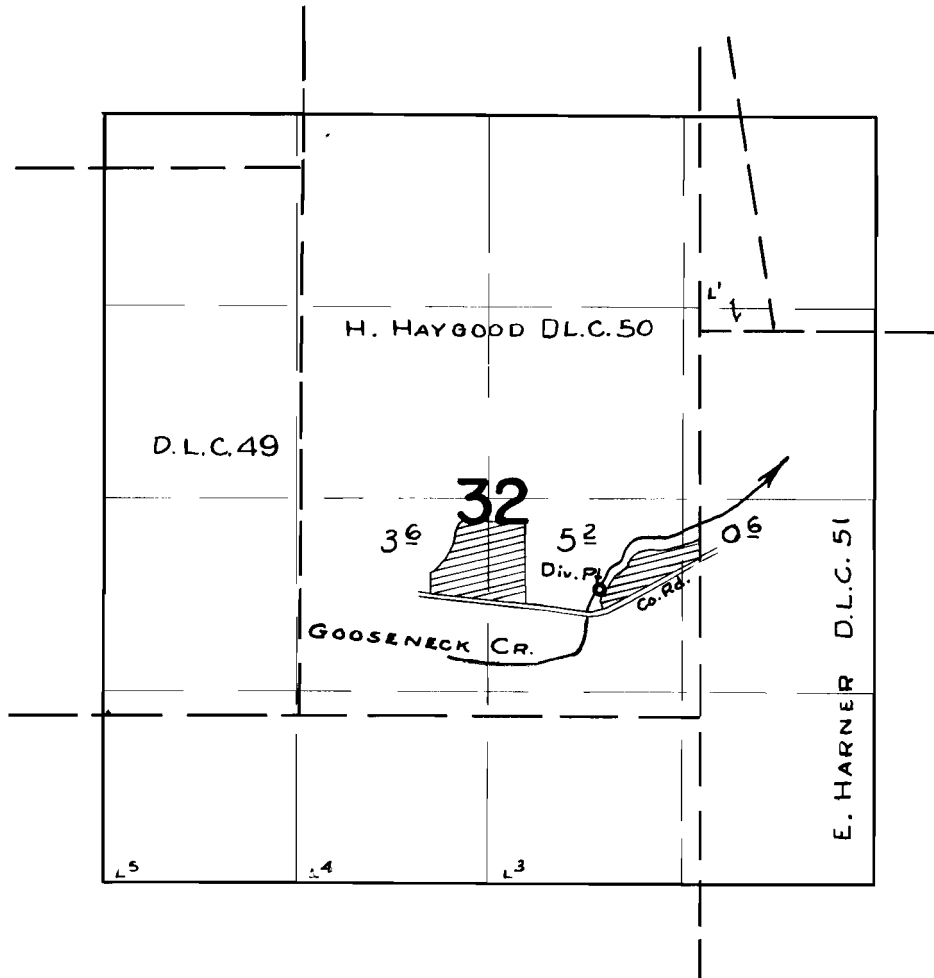

FINAL PROOF SURVEY UNDER

Application No. 31802 Permit No. 25057
IN NAME OF

FRED RHODES

Surveyed 28 JULY 1961, by *m. Bick*