


T. 7 S. R. 3 W. W.M.

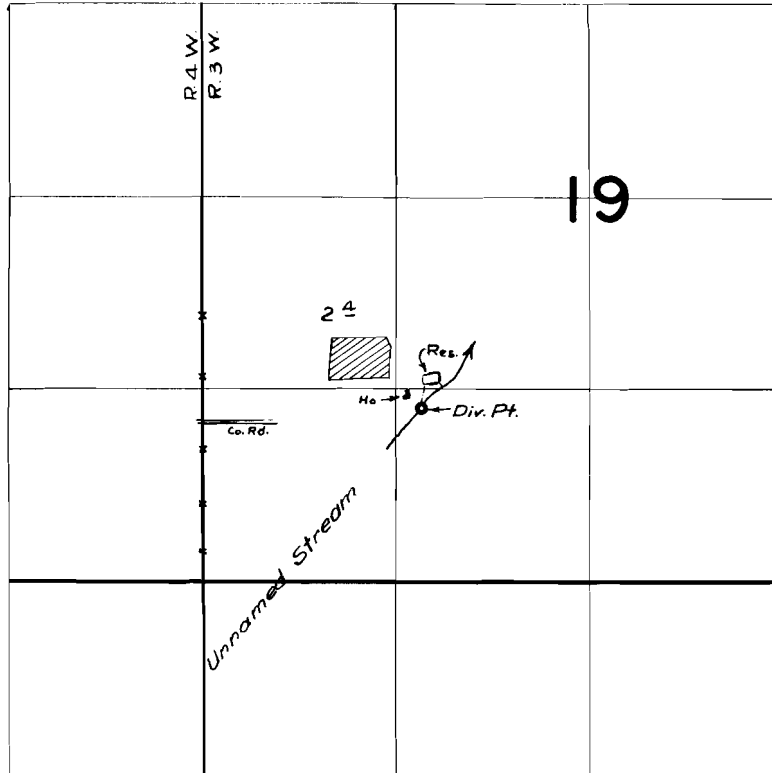

FINAL PROOF SURVEY  
UNDER

Application No. <sup>R-31746</sup> ~~31747~~ Permit No. <sup>R-2079</sup> ~~25144~~  
IN NAME OF

JAMES ANDREW SEXTON

Surveyed 23 MAR. 1961, by M. B. Bish