


T. 6 S. R. 5 W.W.M.

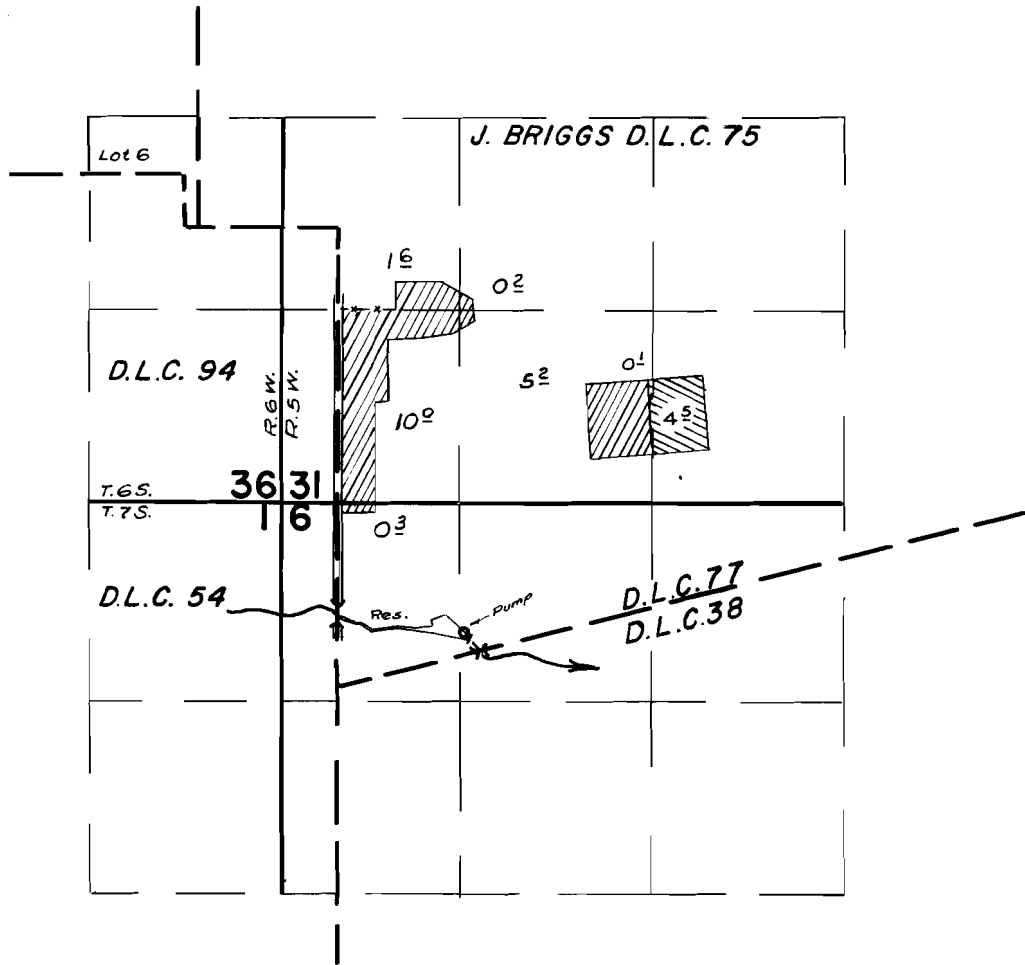

FINAL PROOF SURVEY UNDER

32028 25265
Application No. R-32027 Permit No. R-2104
IN NAME OF

SILAS E. STARR

Surveyed 20 MAR. 1961, by *m. Bish*