T. 6 S. R. 5 W.W.M.

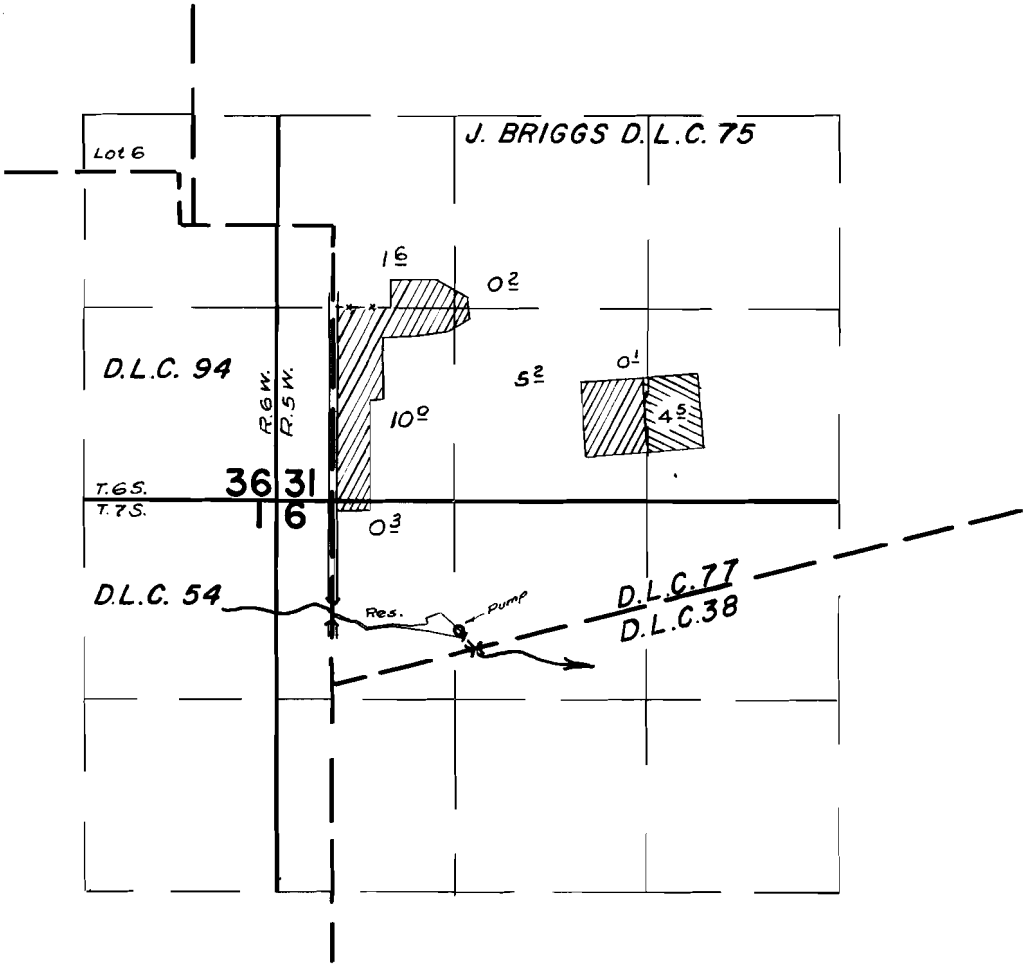

FINAL PROOF SURVEY
UNDER

Application No. R-32027 (32028) Permit No. R-2104 (25265)
IN NAME OF

SILAS E. STARR

Surveyed 20 MAR. 1961, by M. Bish

1961-A
DFP-2P-141