


T. 7S.R. 6W.W.M.

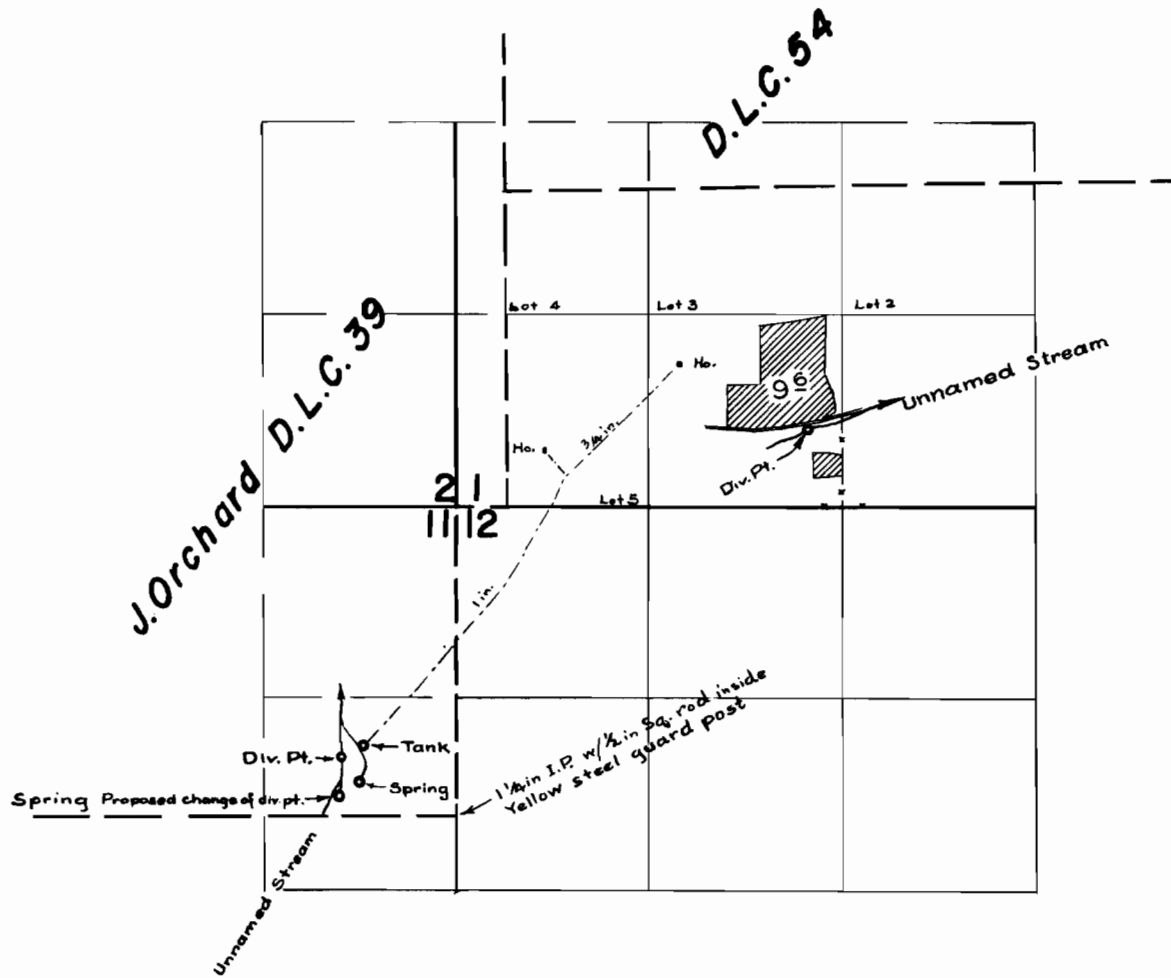

FINAL PROOF SURVEY UNDER

32123 25344
Application No. 32124 Permit No. 25345
IN NAME OF

Chris S. Muller

Surveyed 29-30 Mar 1961, by M. B. Bick