


T. 6 S. R. 5 W. W.M.

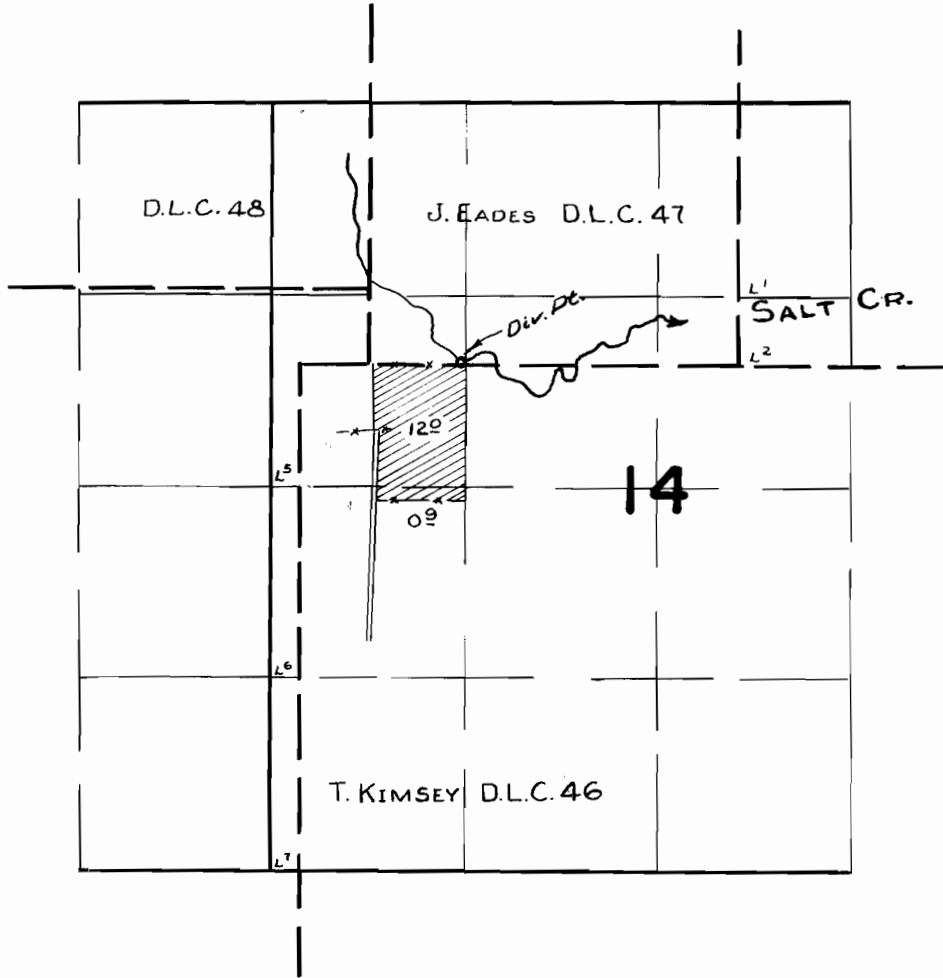

FINAL PROOF SURVEY UNDER

Application No. 32160 ... Permit No. 25372
IN NAME OF

JACOB BAKKER

Surveyed 28 July 1961, by *m. B. Bell*