


T. 9 S. R. 5 W. W. M.

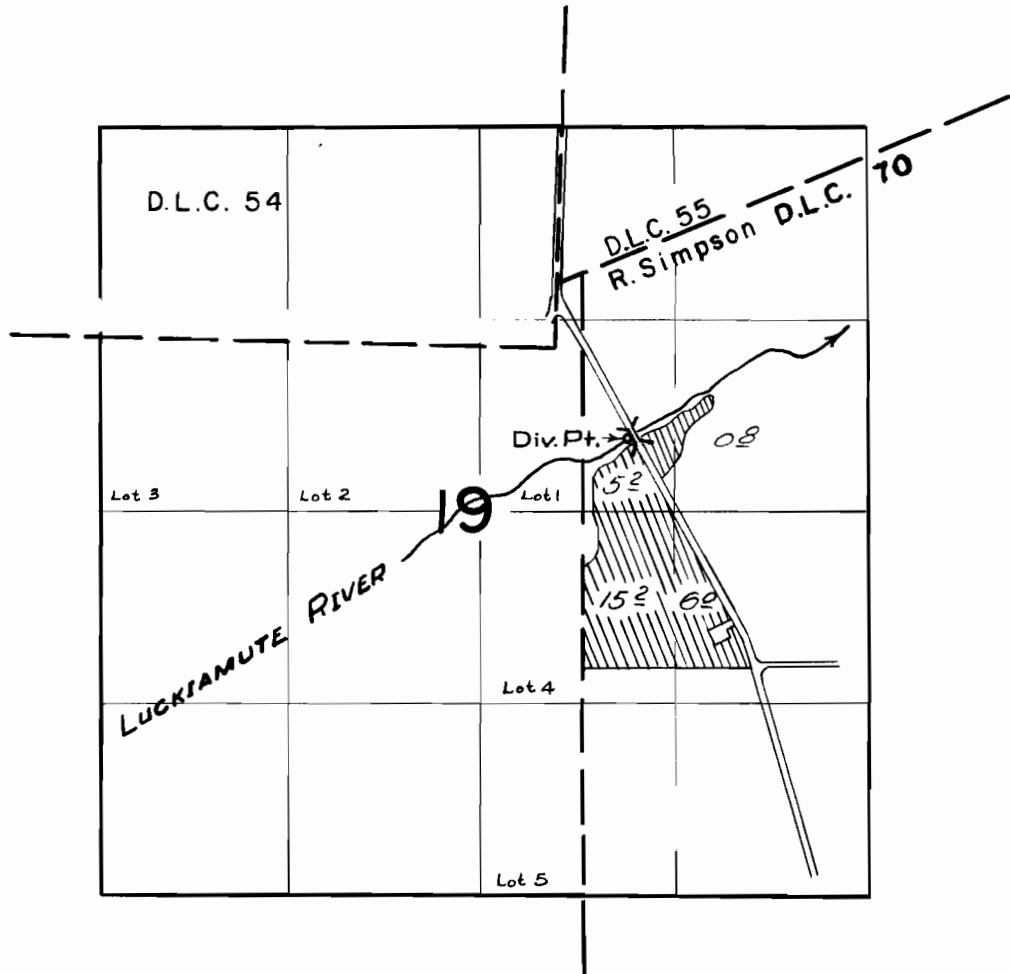

FINAL PROOF SURVEY  
UNDER

Application No. 32175 Permit No. 25385  
IN NAME OF

PAUL WILSON

Surveyed 3 APRIL 1961, by McBish