


# T. 7 S. R. 5 W. W. M.

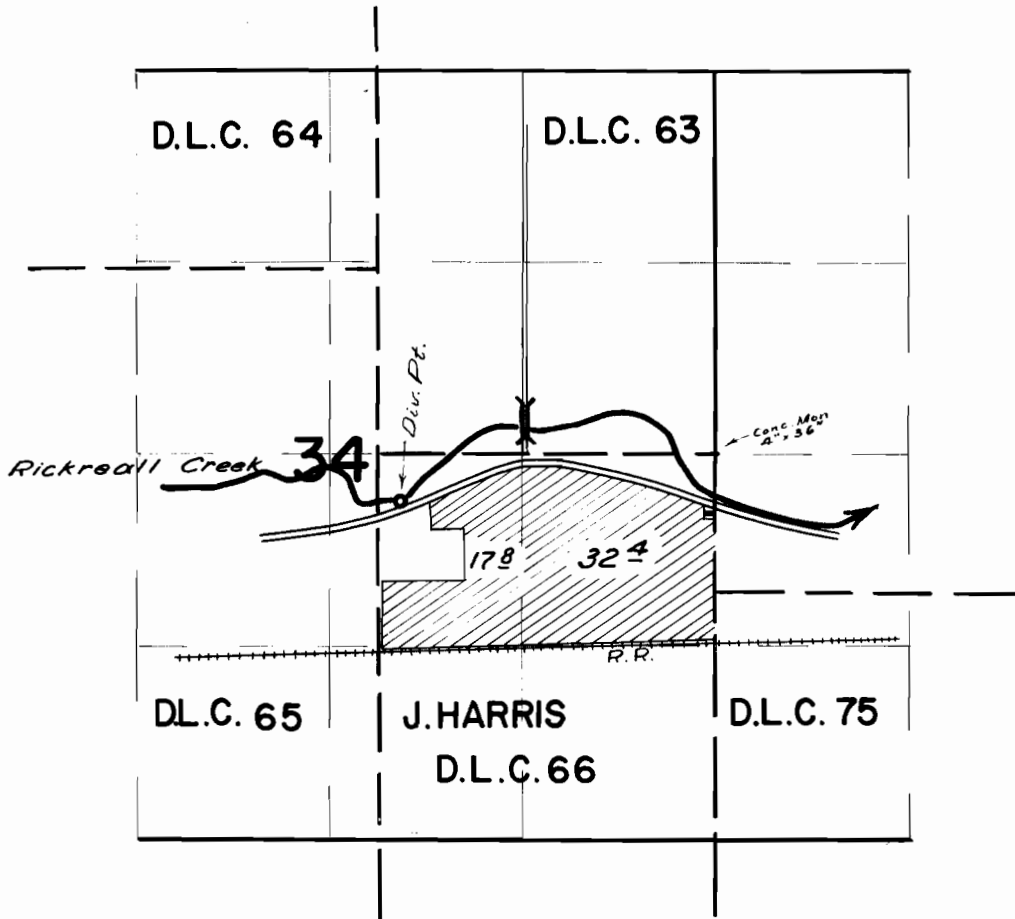

## FINAL PROOF SURVEY UNDER

Application No. 32233 Permit No. 25429  
IN NAME OF

FRANK NEUFELD

Surveyed 27 MAR. 1961, by m. Bish