


T. 1 S. R. 10 W. W. M.

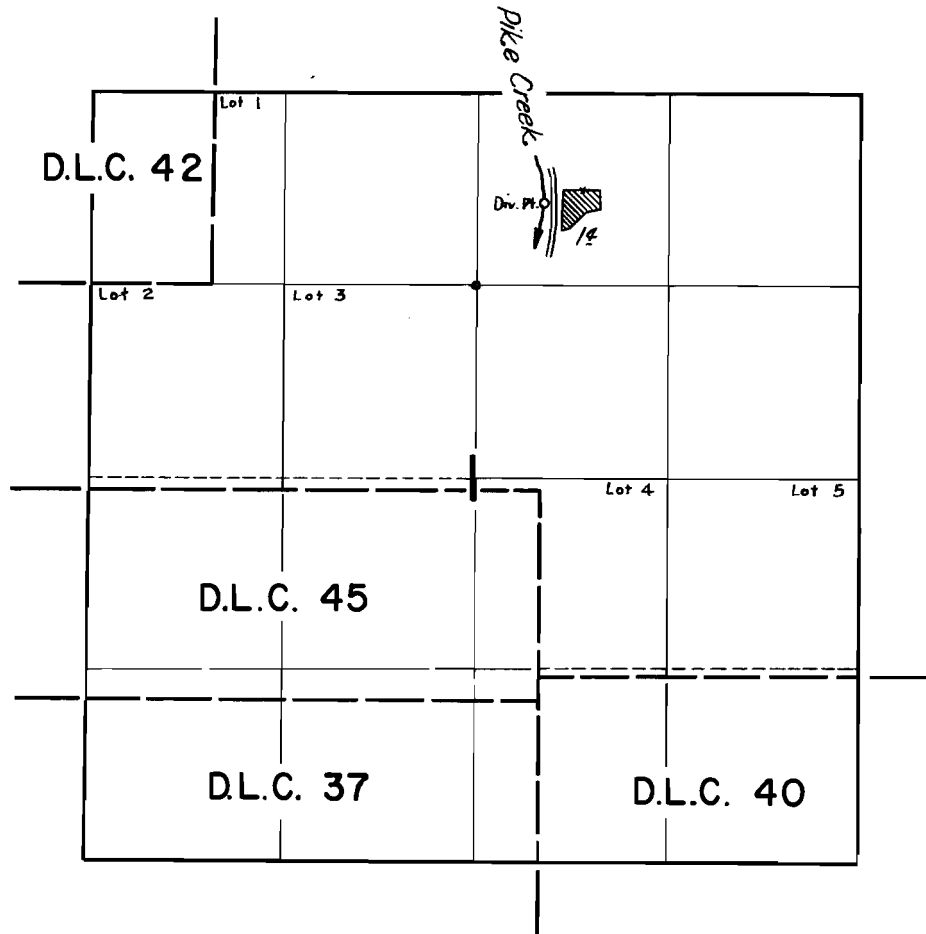

FINAL PROOF SURVEY UNDER

Application No. **30308** Permit No. **23859**
IN NAME OF

VAUGHN ANSTINE

Surveyed *June 26 1961*, by *R. Jackson*