


T.2N.R.10W.W.M.

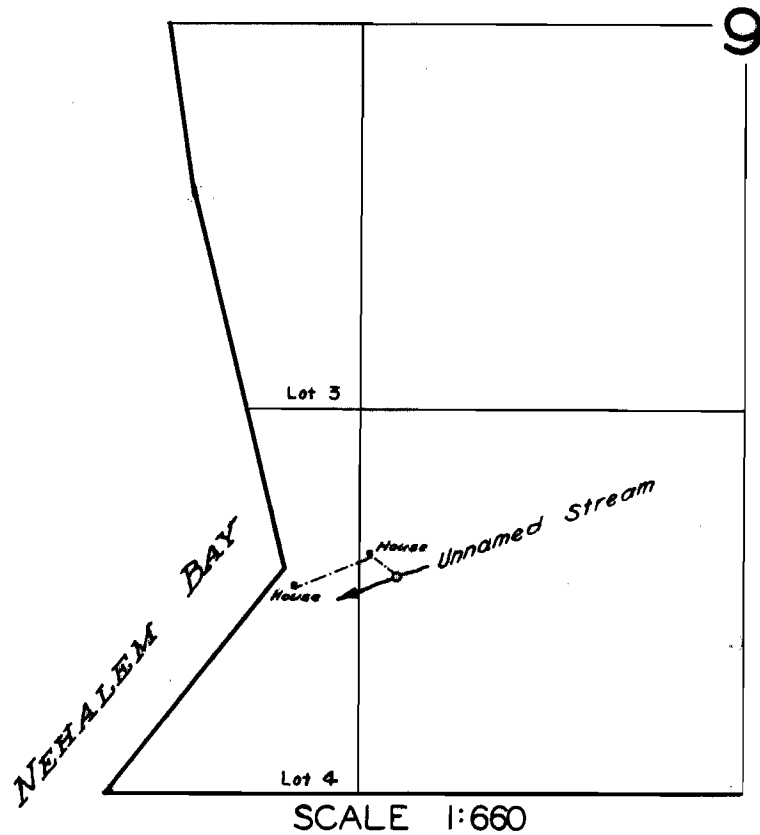

FINAL PROOF SURVEY
UNDER

Application No. 33164 Permit No. 26231
IN NAME OF

CHASE E. DAVIDSON

Surveyed June 28, 1961, by RH Jackson