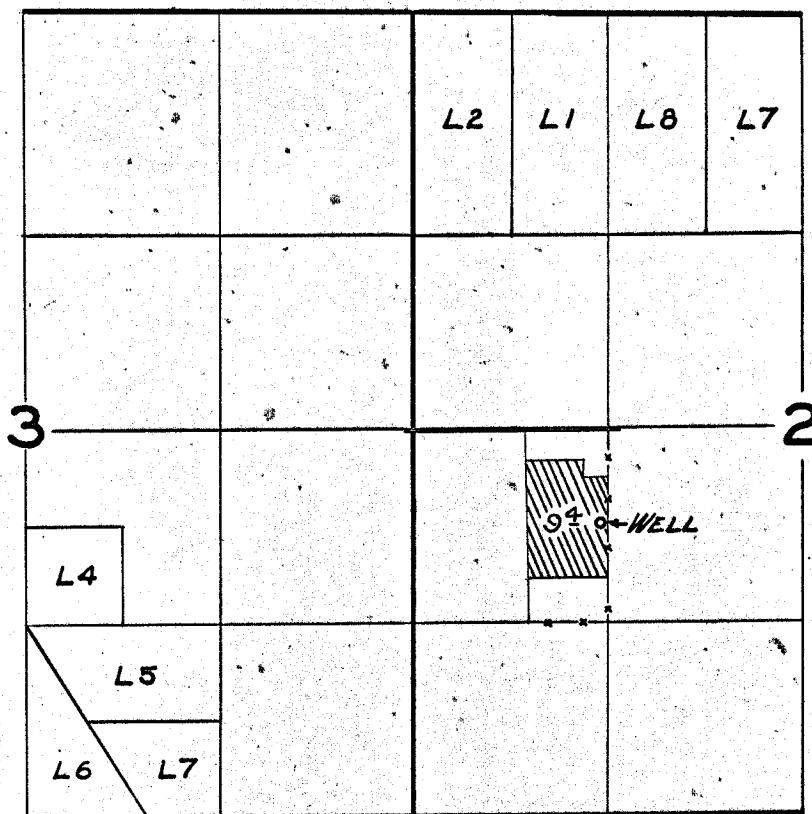


T.4N.R.28E.W.M.

FINAL PROOF SURVEY
UNDERApplication No. G-662.. Permit No. G-628....
IN NAME OFN. WILLARD & LYDIA ROBERTSON

Surveyed JULY 23 1960, by M. BISH.....