T. 2 & 3 S. R. 1 W.W.M.

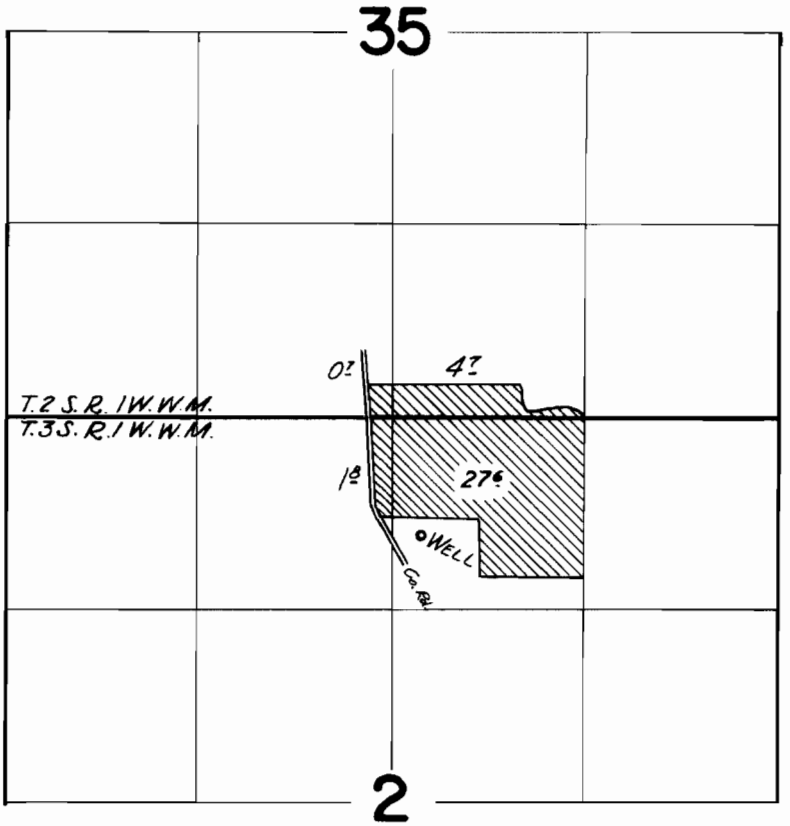

FINAL PROOF SURVEY
UNDER

Application No. G-723 Permit No. G-633
IN NAME OF

A. O. SASAKI

Surveyed June 22 1961, by R. Jackson

DFR-1D-20