


T.3S.R.1W.W.M

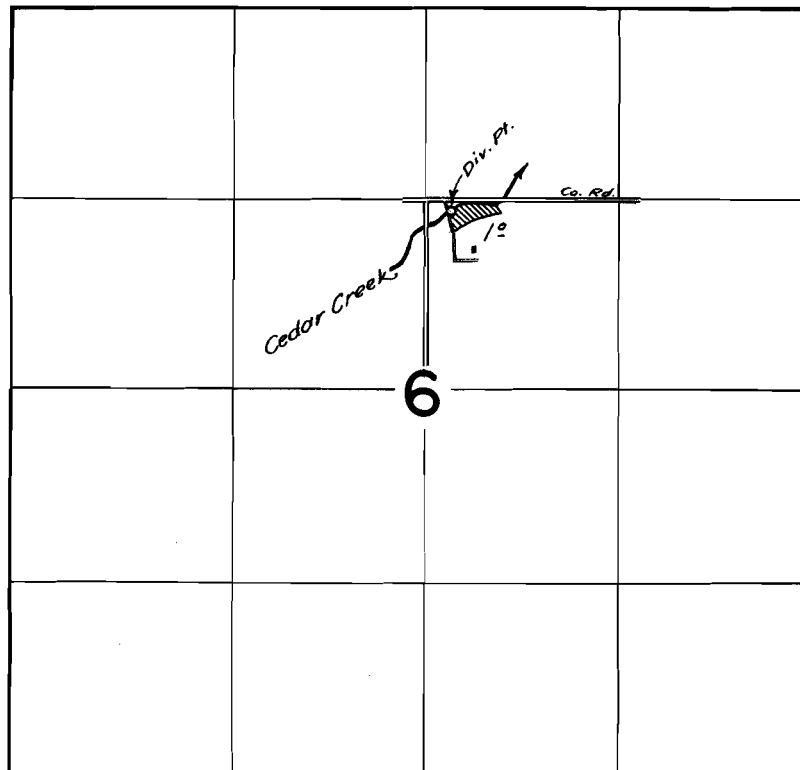

FINAL PROOF SURVEY
UNDER

Application No. **27849** Permit No. **21900**
IN NAME OF

J. I. & PHILIP W. LAPP

Surveyed *August 17 1961*, by *R. H. Jackson*