


T. 1 S. R. 3 W. W.M.

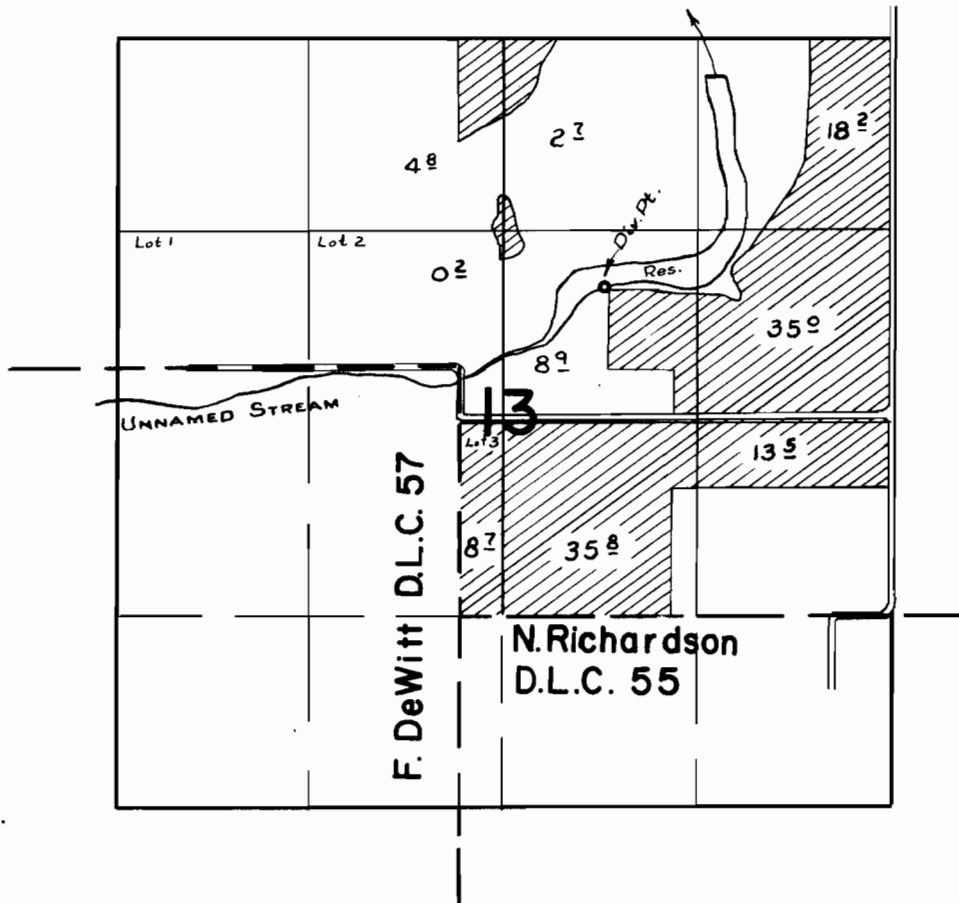

FINAL PROOF SURVEY
UNDER

Application No. 28078 Permit No. 22084
IN NAME OF

PAUL BAILEY, M.D.

Aug. 9 1961 *m. B. B.*
Surveyed MAY 29 1960, by R. JACKSON