


T.2S.R.2W.W.M.

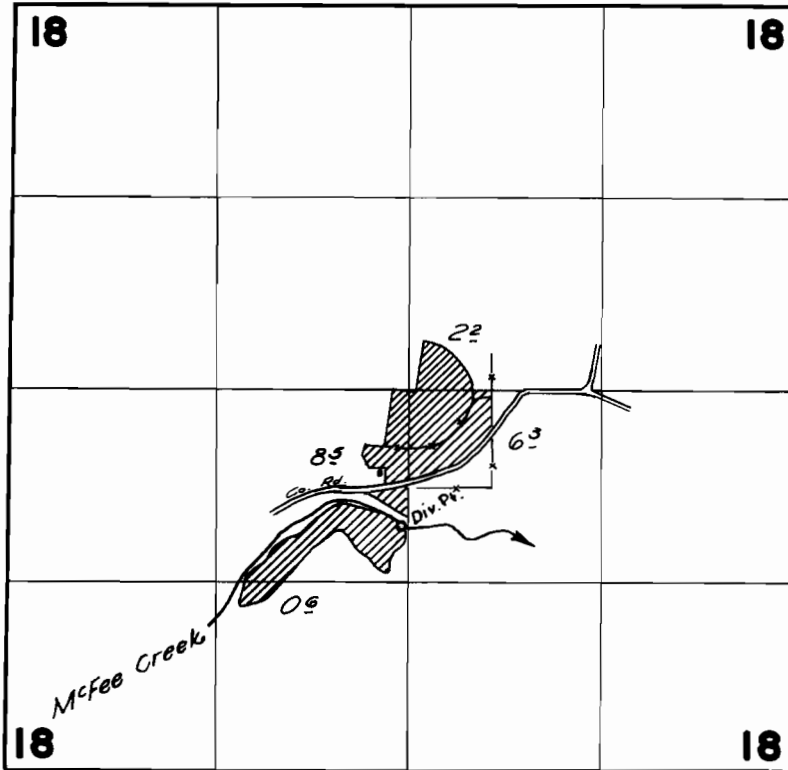

FINAL PROOF SURVEY UNDER

Application No. 32218 Permit No. 25421
IN NAME OF

RAY J. MANN

Surveyed August 18 1961, by *R. H. Jackson*