


T.2S.R.1W.W.M.

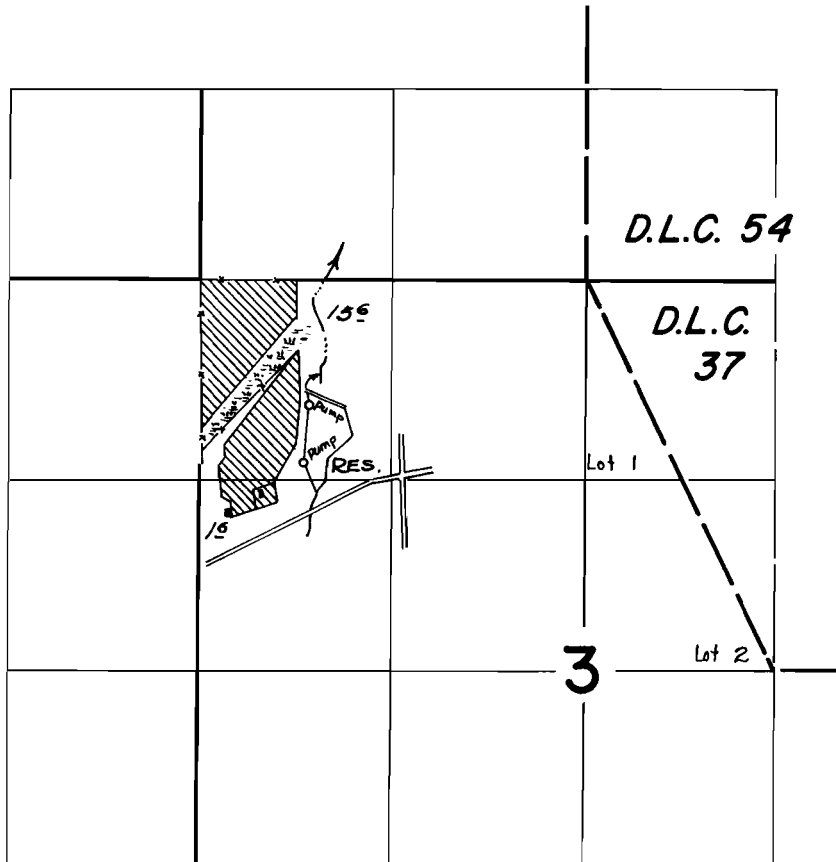

FINAL PROOF SURVEY UNDER

R-32350 R-2146
Application No. 32351 Permit No. 25531
IN NAME OF

..... LYLE D. GOODELL

Surveyed August 17, 1961, by *[Signature]*