


# T.2S.R.1W.W.M.

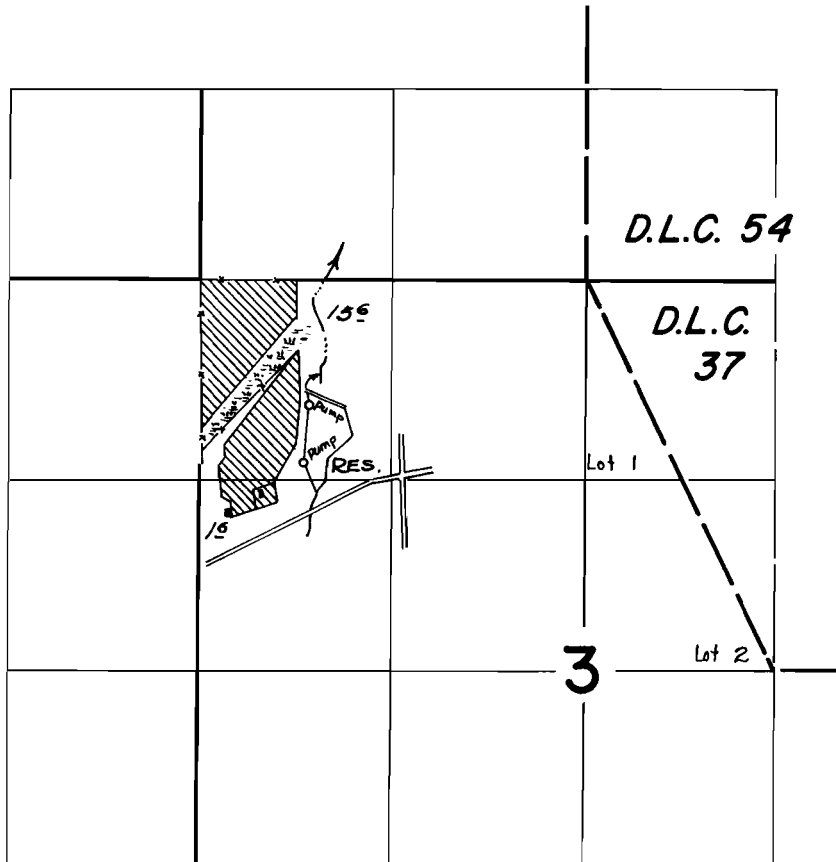

## FINAL PROOF SURVEY UNDER

R-32350                      R-2146  
Application No. 32351    Permit No. 25531  
IN NAME OF

..... LYLE D. GOODELL .....

Surveyed August 17, 1961, by *[Signature]*