


T. 5 S. R. 3 W. W. M.

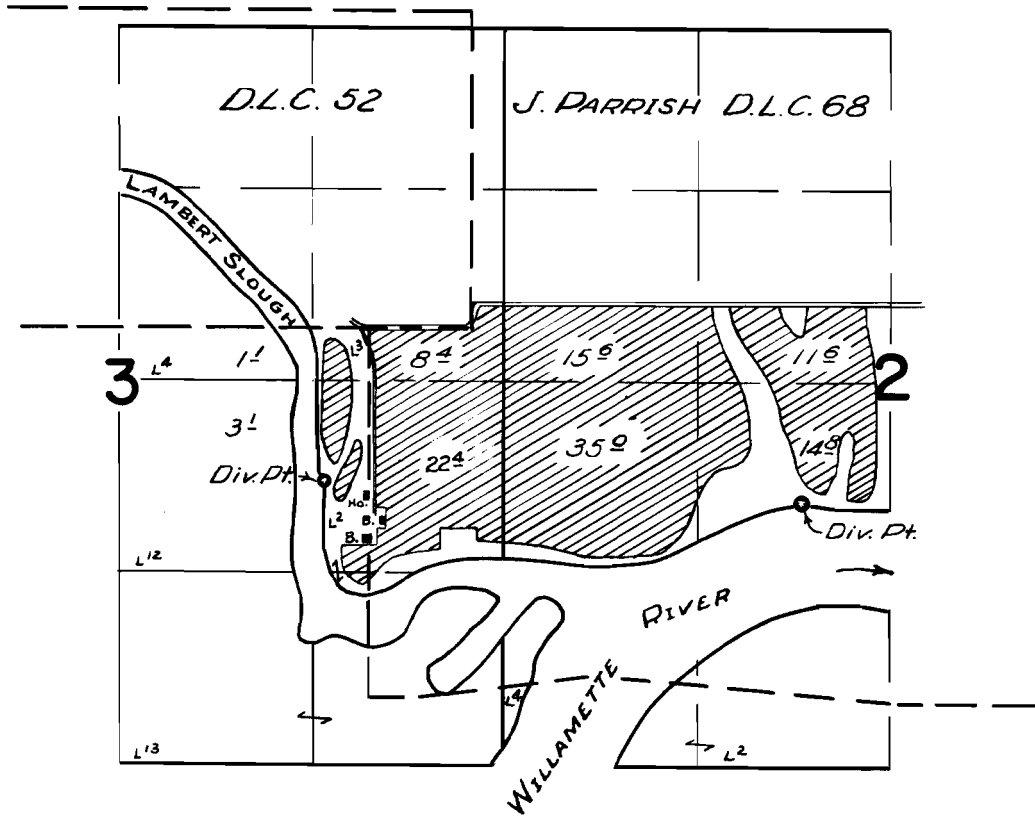

FINAL PROOF SURVEY UNDER

Application No. 31318 Permit No. 24663
IN NAME OF

ED RICHARDS

Surveyed 26 APRIL 1961, by M. Bich