


T. 3 S. R. 5 W. W. M.

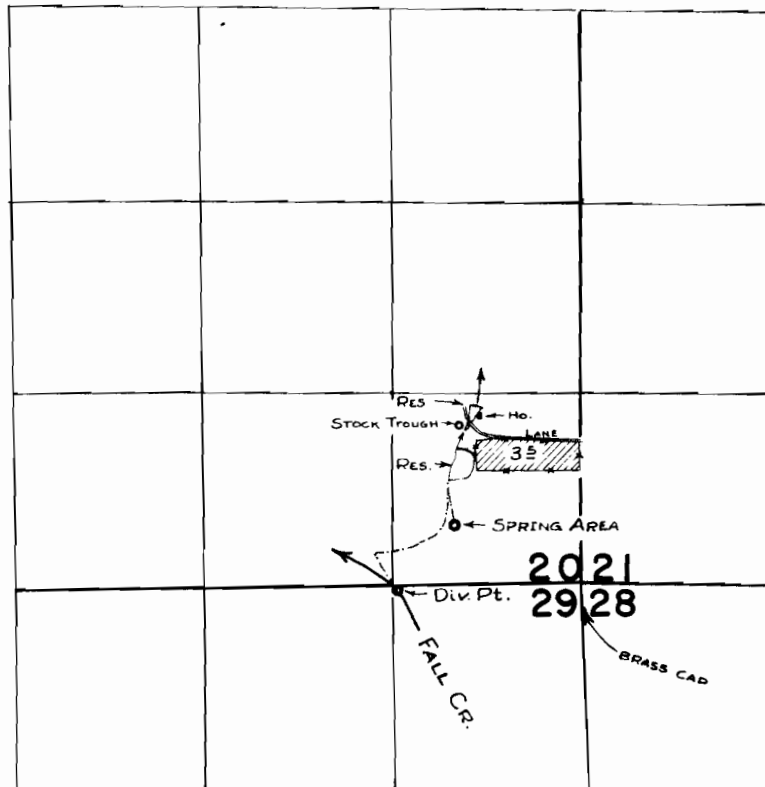

FINAL PROOF SURVEY
UNDER

31423 24762
Application No. *R-31436* Permit No. *R-1999*
IN NAME OF

ELMER BACHMANN

Surveyed 7 APRIL 1961, by *Wm. Bish*