


T. 4 S. R. 4 W. W.M.

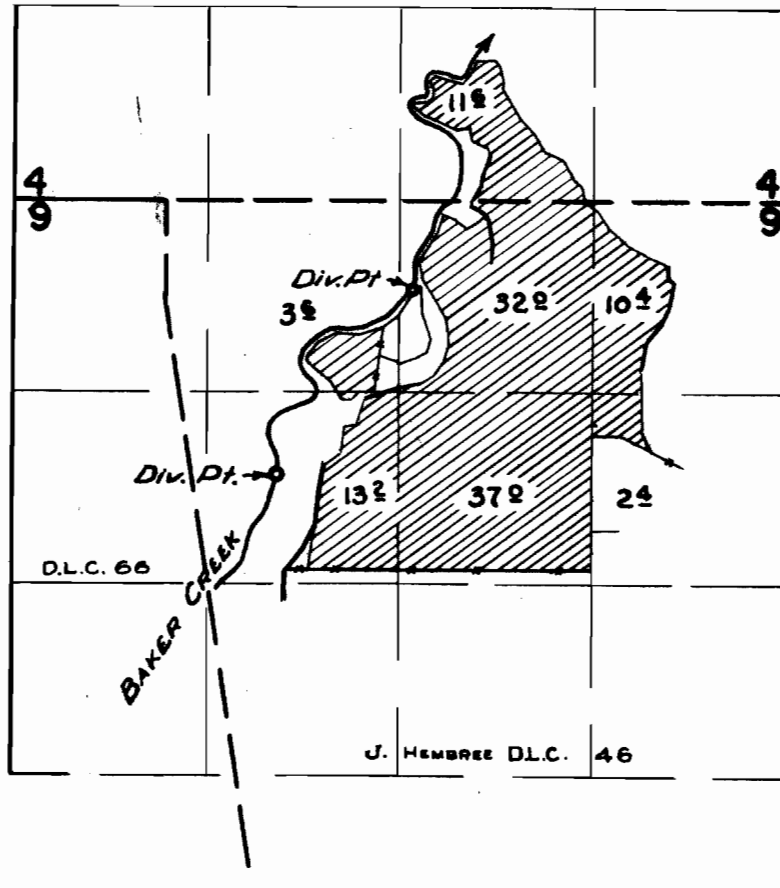

FINAL PROOF SURVEY
UNDER

Application No. 32024 Permit No. 25263
IN NAME OF

HERBERT C. COLEMAN

Surveyed 5 APRIL 1961
31 MAY 1960, by [Signature]