


# T. 5 S. R. 7 W. W. M.

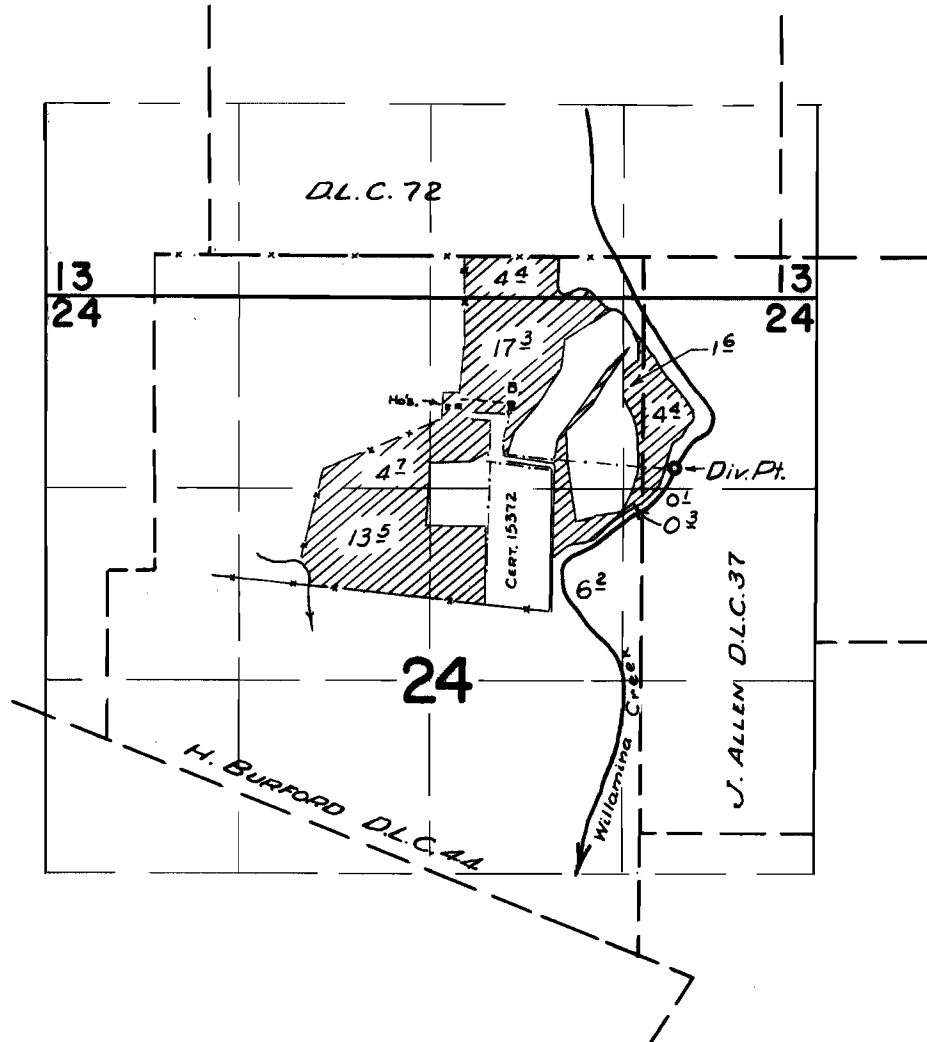

## FINAL PROOF SURVEY UNDER

Application No. 33179 Permit No. 26243  
IN NAME OF

HAROLD L. MENDENHALL

Surveyed 28 APRIL 1961, by m. Bish