


T. 5 S. R. 3 W. W.M.

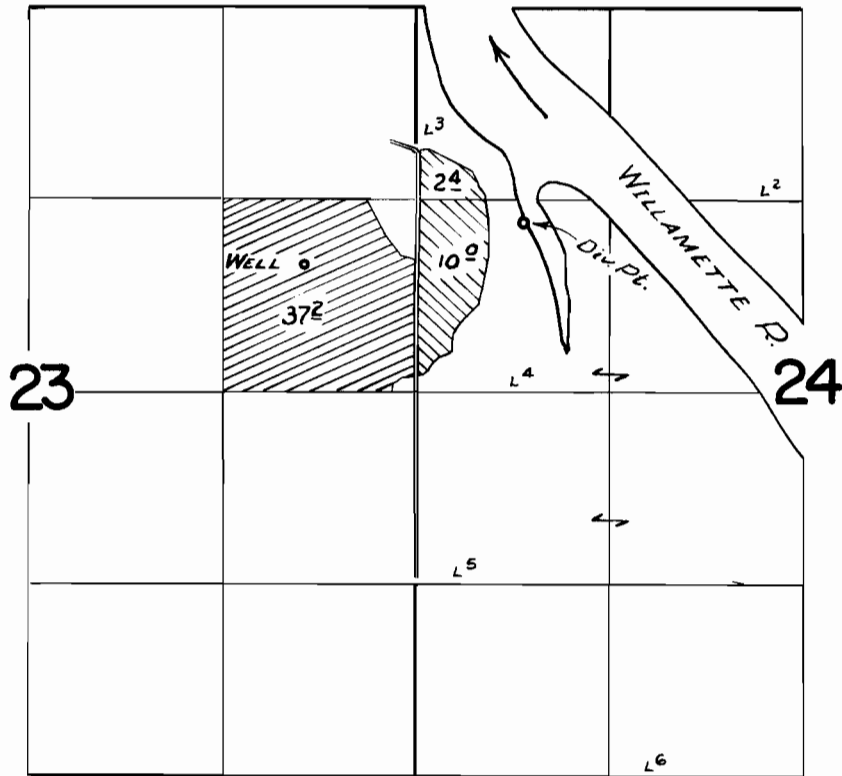

FINAL PROOF SURVEY UNDER

34429

27040



Application No. G-1278 Permit No. G-1085
IN NAME OF



DELTA CULP

Surveyed 27 APRIL 1961, by M. Bish