


# T. 7 S. R. 6 W. W.M.

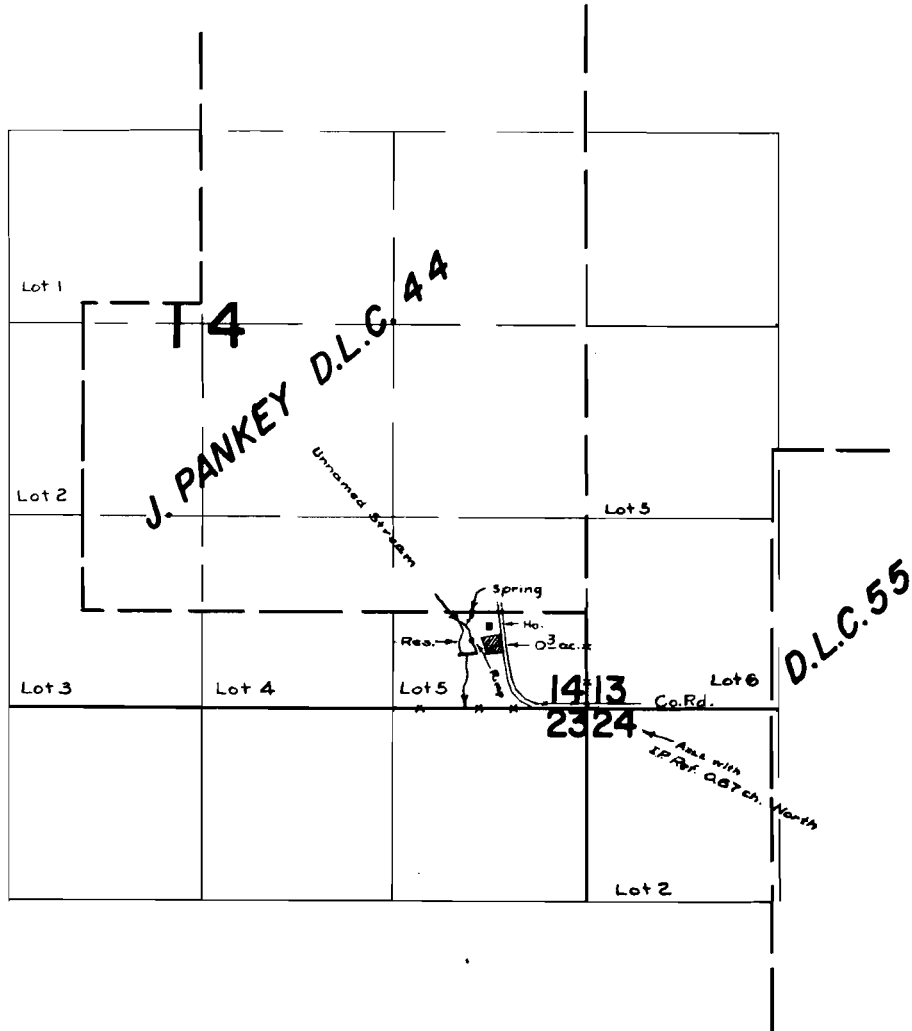

## FINAL PROOF SURVEY UNDER

31783                      25051  
Application No. R-31782 Permit No. R-2059  
IN NAME OF

NORMAN WILSON

Surveyed 30 March 1961, by m. Bish