


T.4 S.R.1E.&1W.W.M.

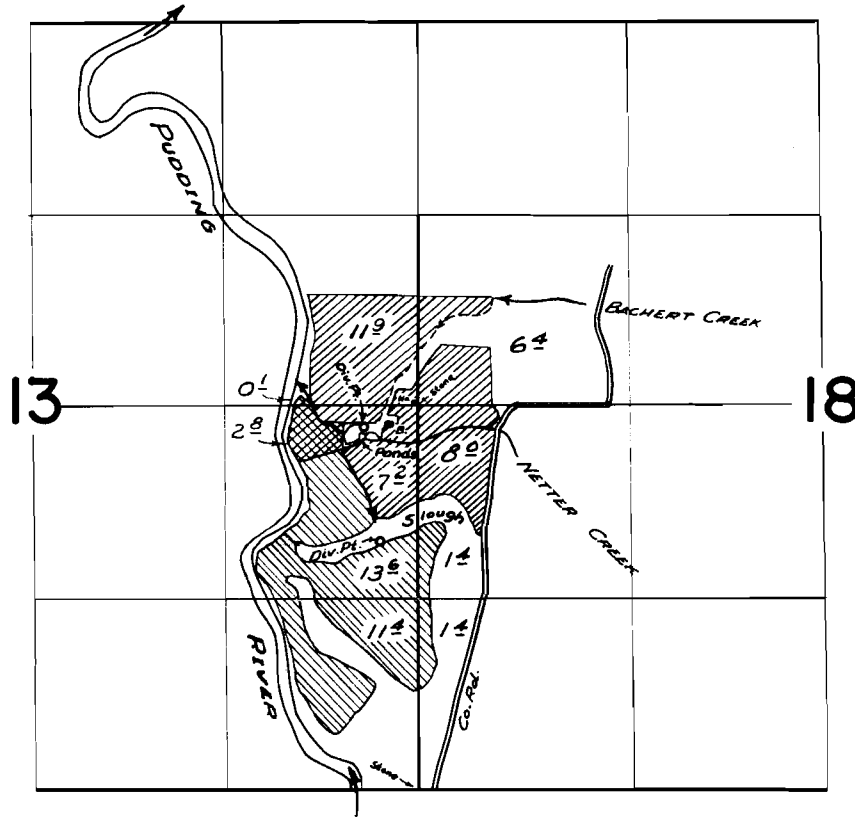

FINAL PROOF SURVEY

UNDER

SLOUGH 
NETTER CREEK 

Application No. 32020 Permit No. 25259
IN NAME OF

ARMIN NETTER

Surveyed 1 MAY 1959 by *Mr. Bish*