


T.3S.R.3E.W.M.

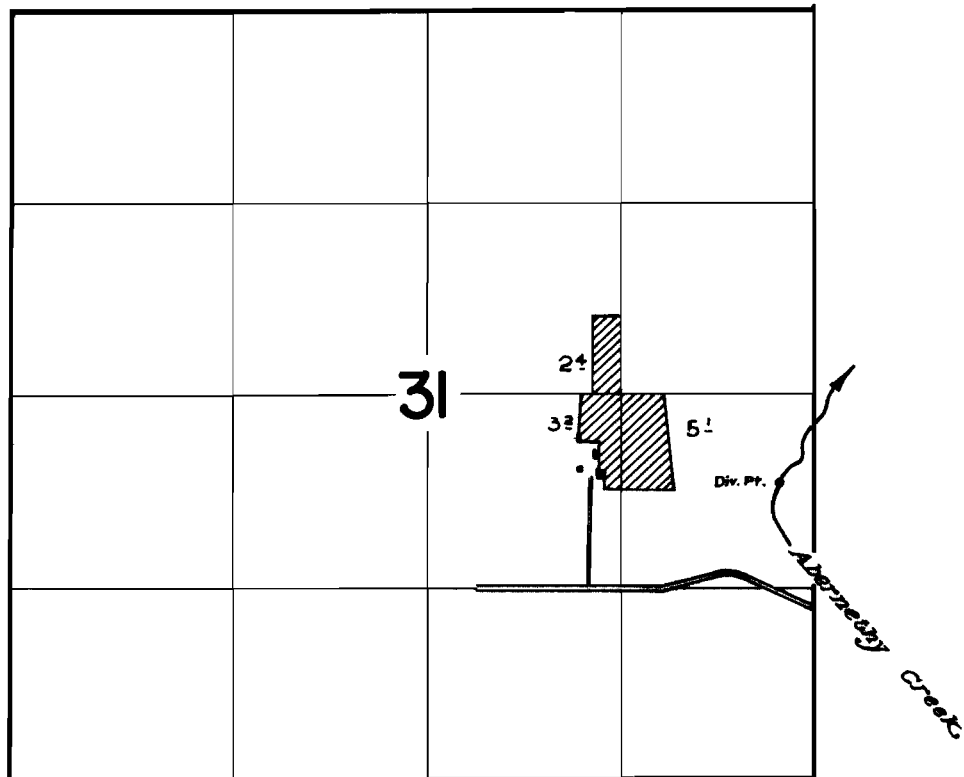

FINAL PROOF SURVEY
UNDER

Application No. 30736 Permit No. 24219
IN NAME OF

AVERIL MOEHNKE

Surveyed April 27 1961, by R. Jackson