


# T.2S.R.1E.W.M.

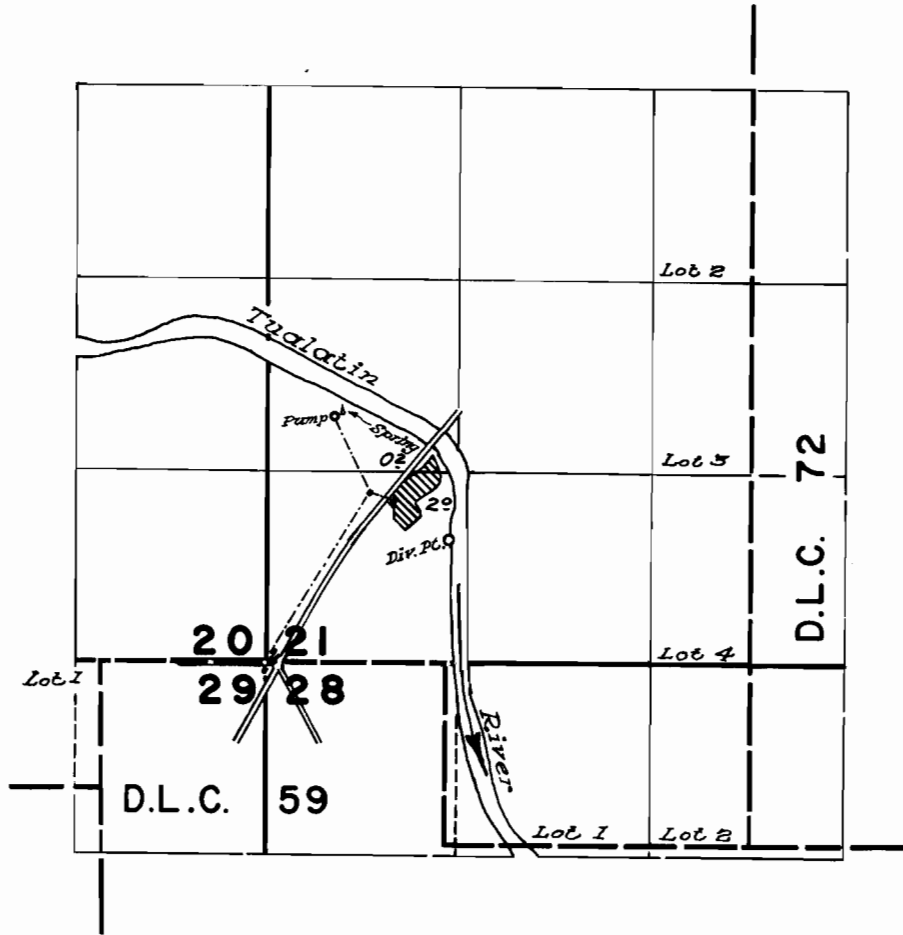

## FINAL PROOF SURVEY UNDER

Application No. 32426. Permit No. 25598.  
IN NAME OF  
**Gladys V. Hollabaugh, Mabel Gray and  
Lloyd and Walter J. Wanker**

Surveyed April 4, 1961, by *R. Jackson*