


T.20S.R.7W.W.M.

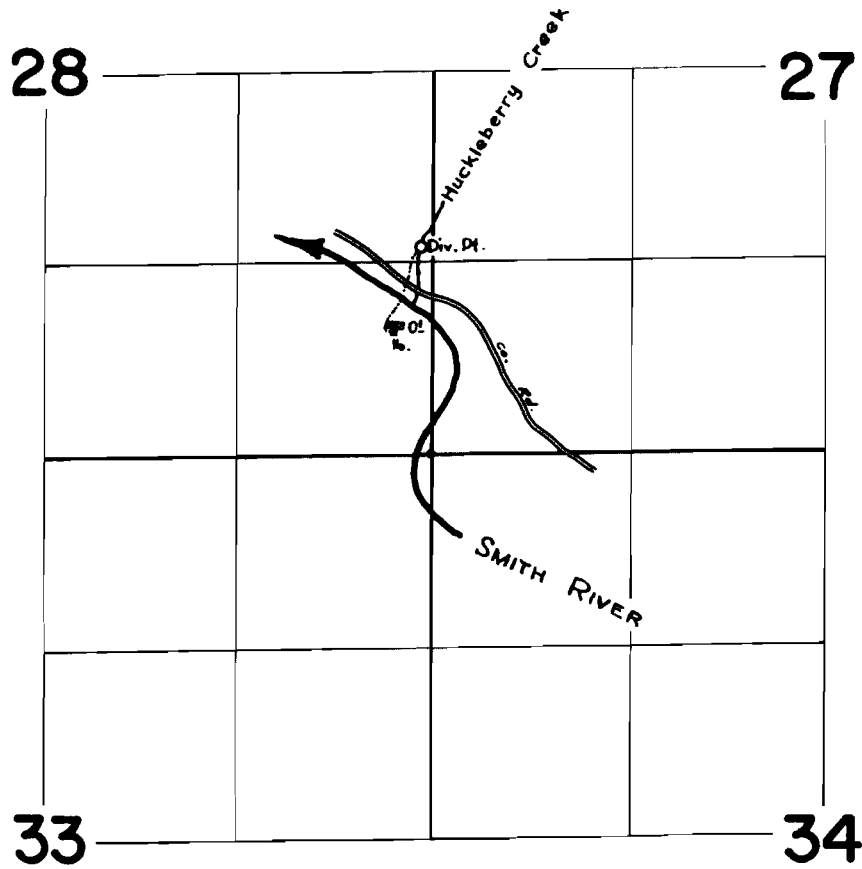

FINAL PROOF SURVEY UNDER

Application No. **22442**. Permit No. **.17.7.10....**
IN NAME OF

.....
Surveyed March 29 1961., by

[Signature]