T.22S.R.9W.W.M.

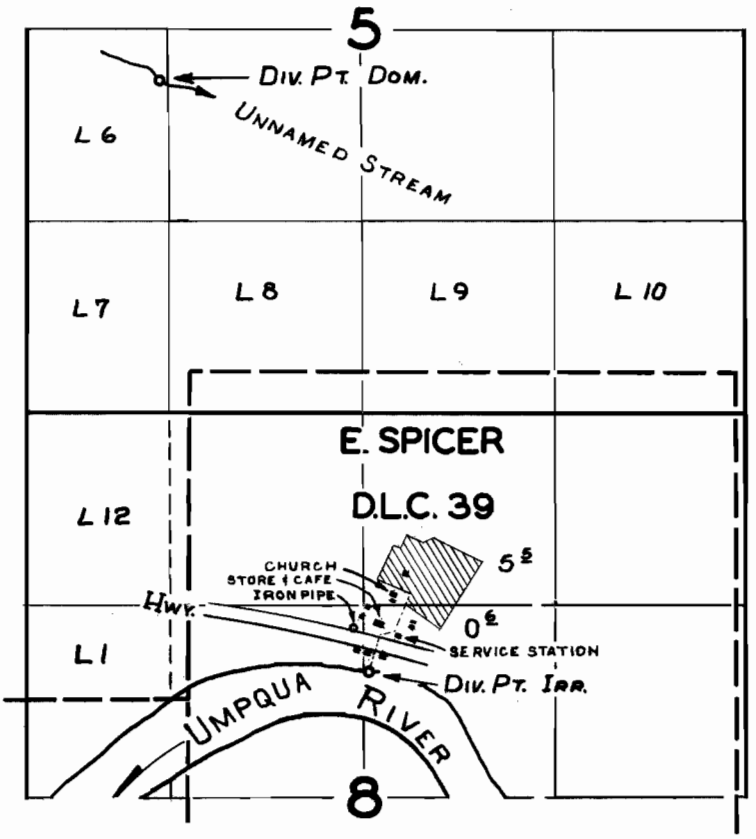

FINAL PROOF SURVEY
UNDER

Application No. 29062 (29072) Permit No. 23802 (23803)
IN NAME OF

EVERETT & EVELINE HENDRICKSON

Surveyed JUNE 30.1960, by C. O. BARTELS

1960·X B.C.