


T.22S.R.9W.W.M.

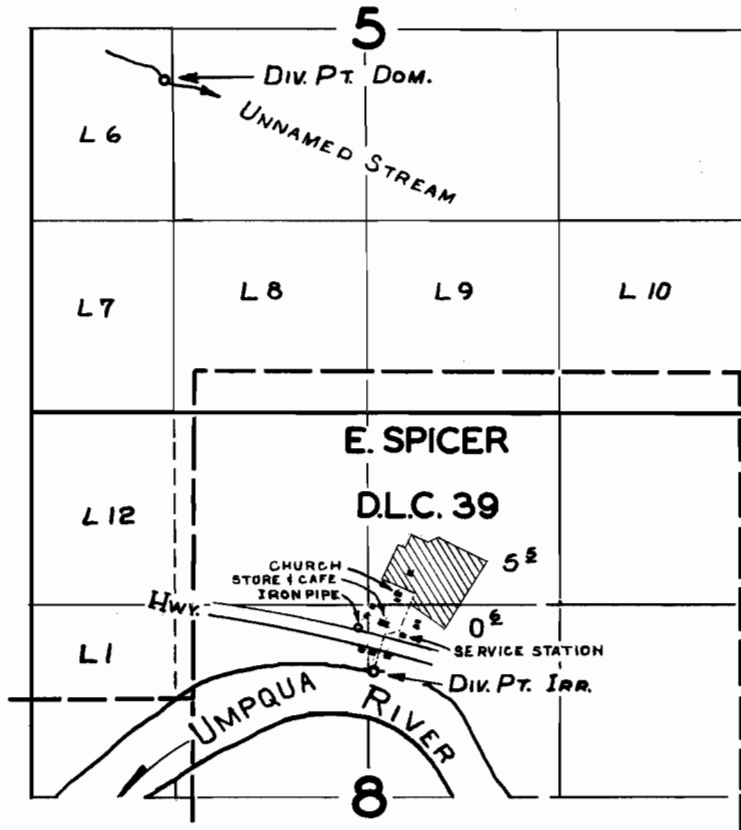

FINAL PROOF SURVEY
UNDER

Application No. 29072 23803
29062 Permit No. 23802
IN NAME OF

.....EVERETT & EVELINE HENDRICKSON.....

Surveyed JUNE 30, 1960, by C.O. BARTELS