


T.25S.R.6&7 W.W.M.

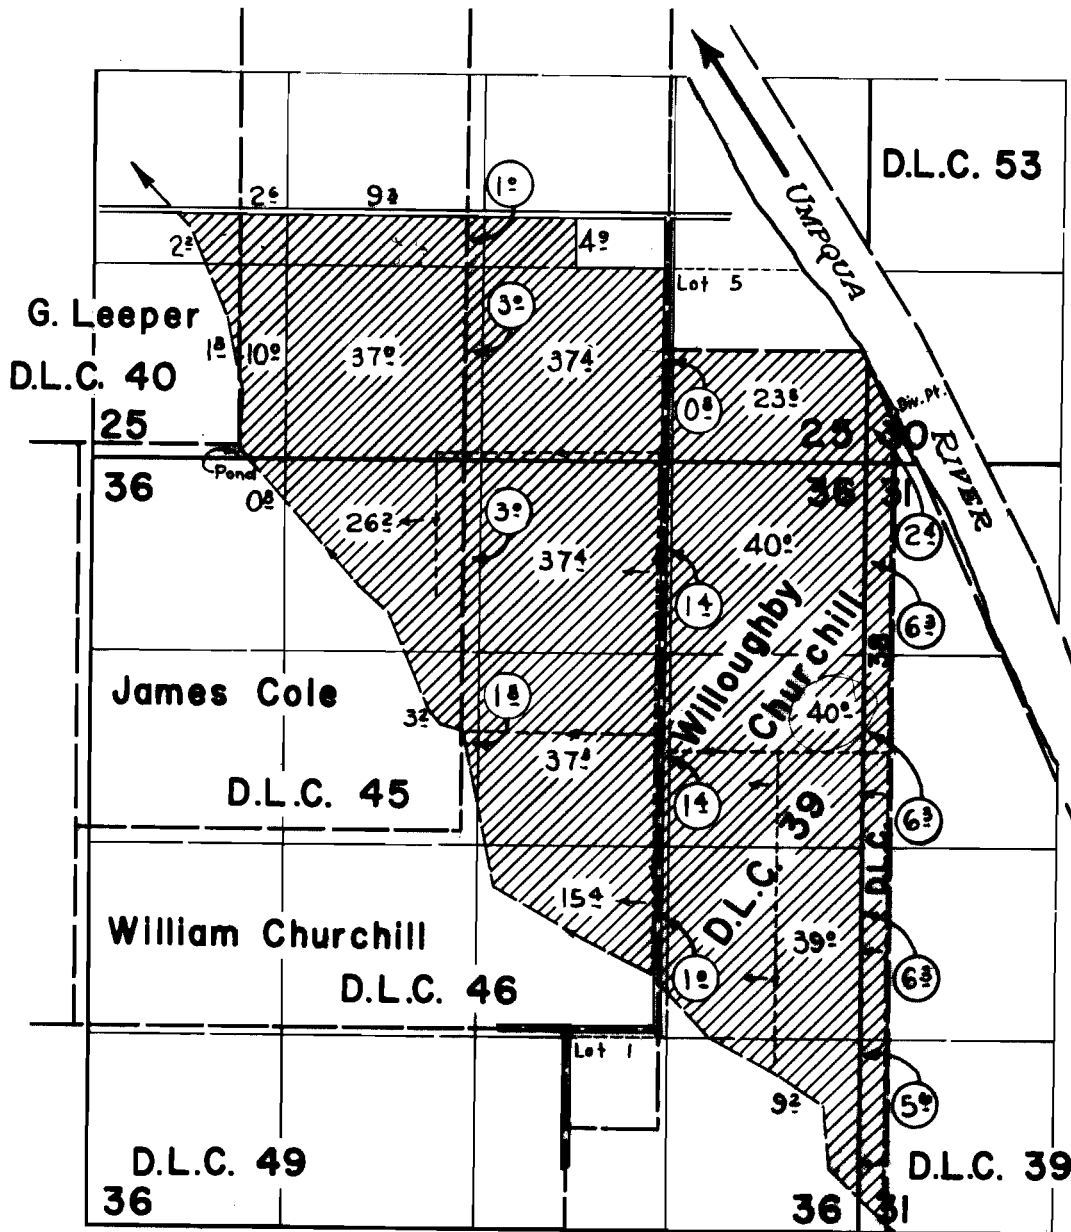

FINAL PROOF SURVEY UNDER

Application No. **30483** Permit No. **24008**
IN NAME OF

Surveyed May 4, 1961, by *D. Jackson*