


T.22S.R.9W.W.M.

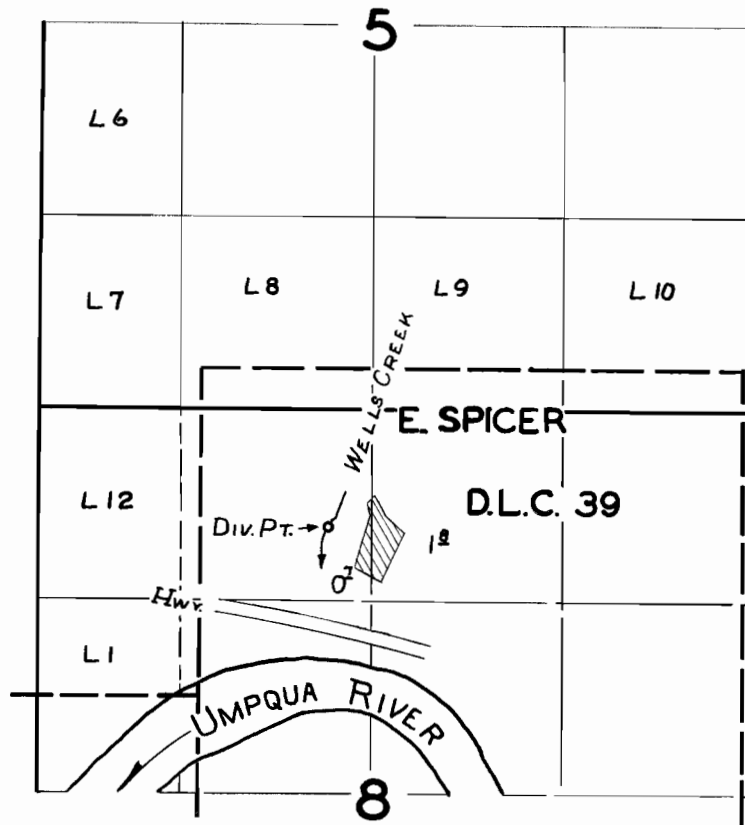


FINAL PROOF SURVEY
UNDER

Application No. 31335... Permit No. 24787...
IN NAME OF

..... WILMER C. & MAY E. LOWE

Surveyed JULY 1, 1960, by C. O. BARTELS.

T. 22 S. R. 9 W. W. M.

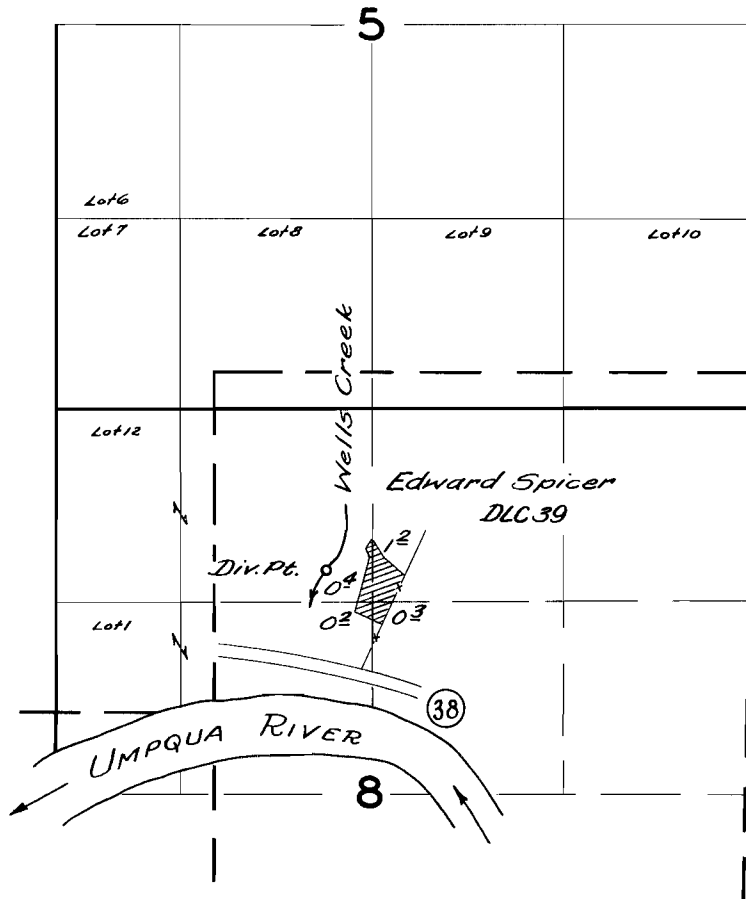

FINAL PROOF SURVEY
UNDER

Application No. 31335... Permit No. 24187...
IN NAME OF

..... WILMER C. & MAY E. LOWE

Surveyed July 1, 1960, by C. O. Smith