


T.27S.R.3 W.W.M.

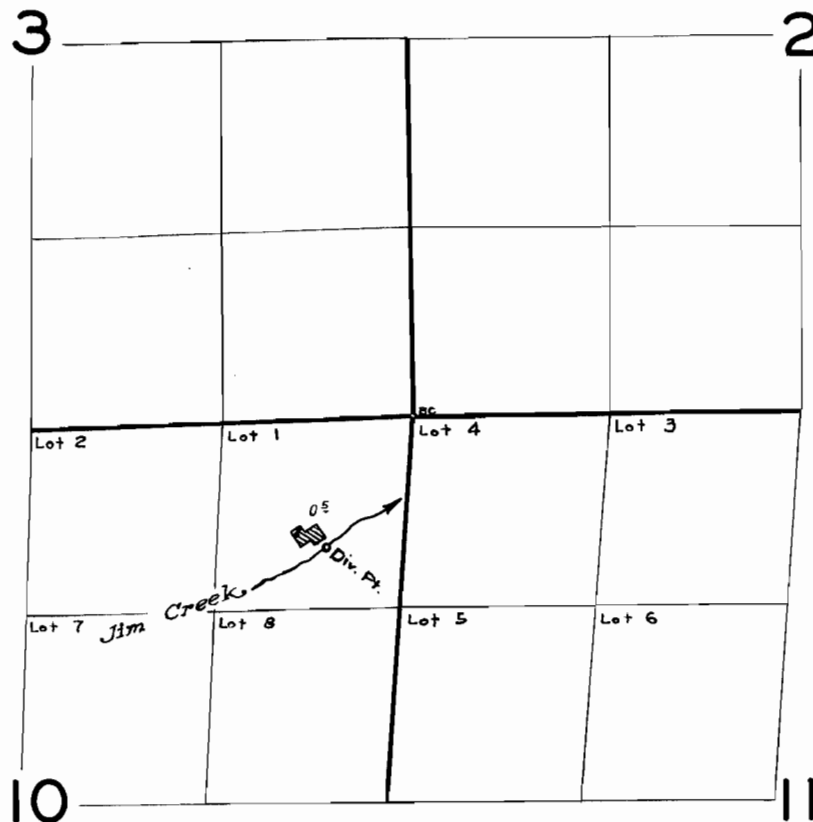

FINAL PROOF SURVEY
UNDER

Application No. 31539... Permit No. 24892
IN NAME OF

GLENN C. SNIDER & ELNORA H. SNIDER

Surveyed May 1, 1961, by *R. H. Jackson*