


T.27S.R.6W.W.M.

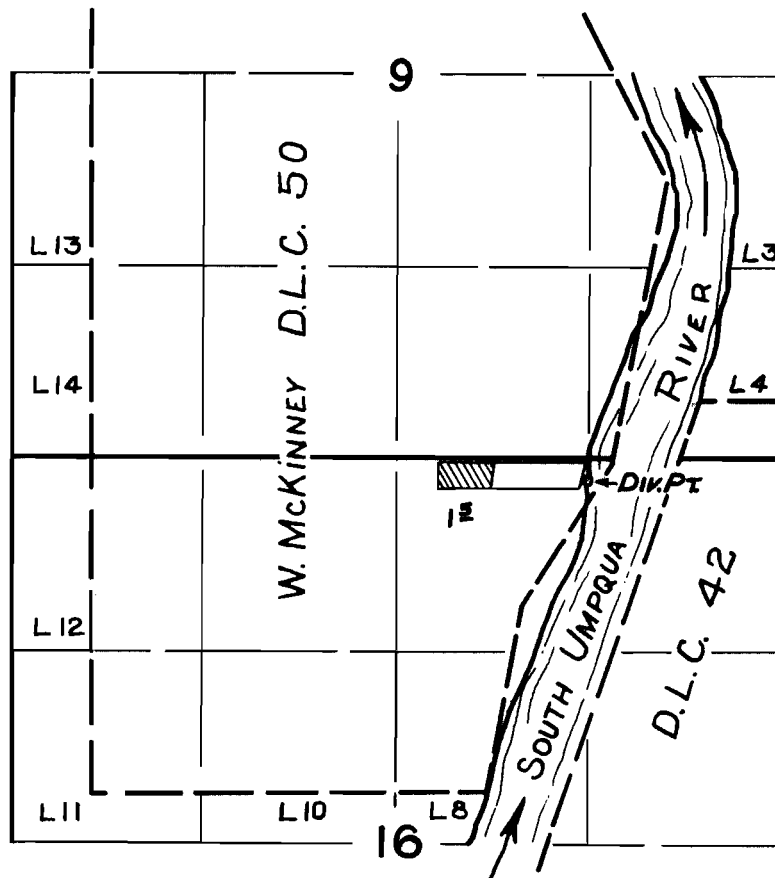

**FINAL PROOF SURVEY**  
UNDER

Application No. 324.43 Permit No. 25610...  
IN NAME OF

...FRANKLIN R. & WINZORA... B. PAUL...

Surveyed MAY 5... 1961, by C. D. BARTELS