


T.22S.R.9W.W.M.

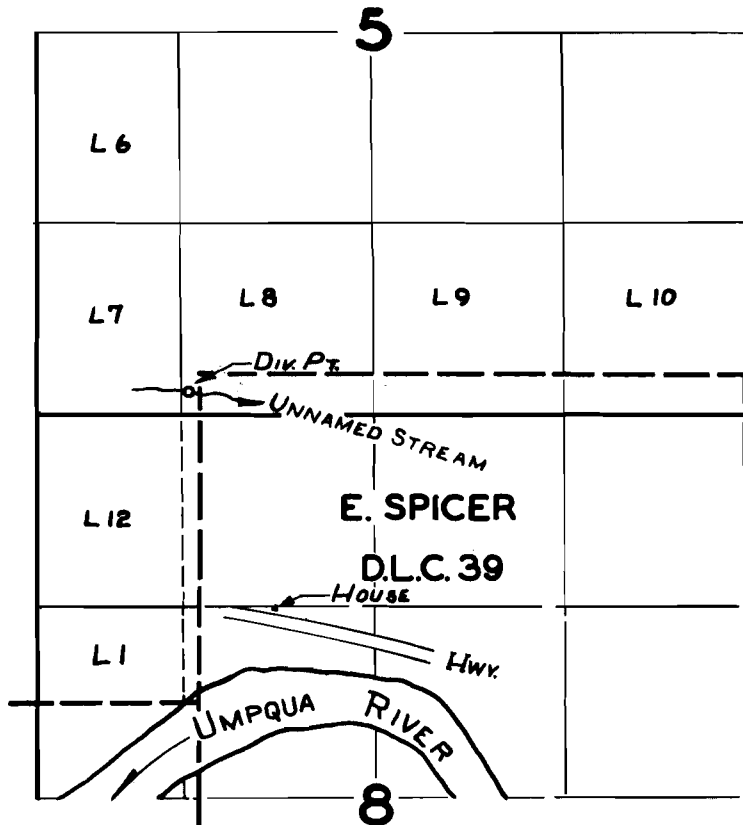

FINAL PROOF SURVEY
UNDER

Application No. 32527... Permit No. 25774...
IN NAME OF

.....MAUD L. JACKSON.....

Surveyed JULY 1, 1960, by C. Q. BARTELS.