


T.26S.R.7W.W.M.

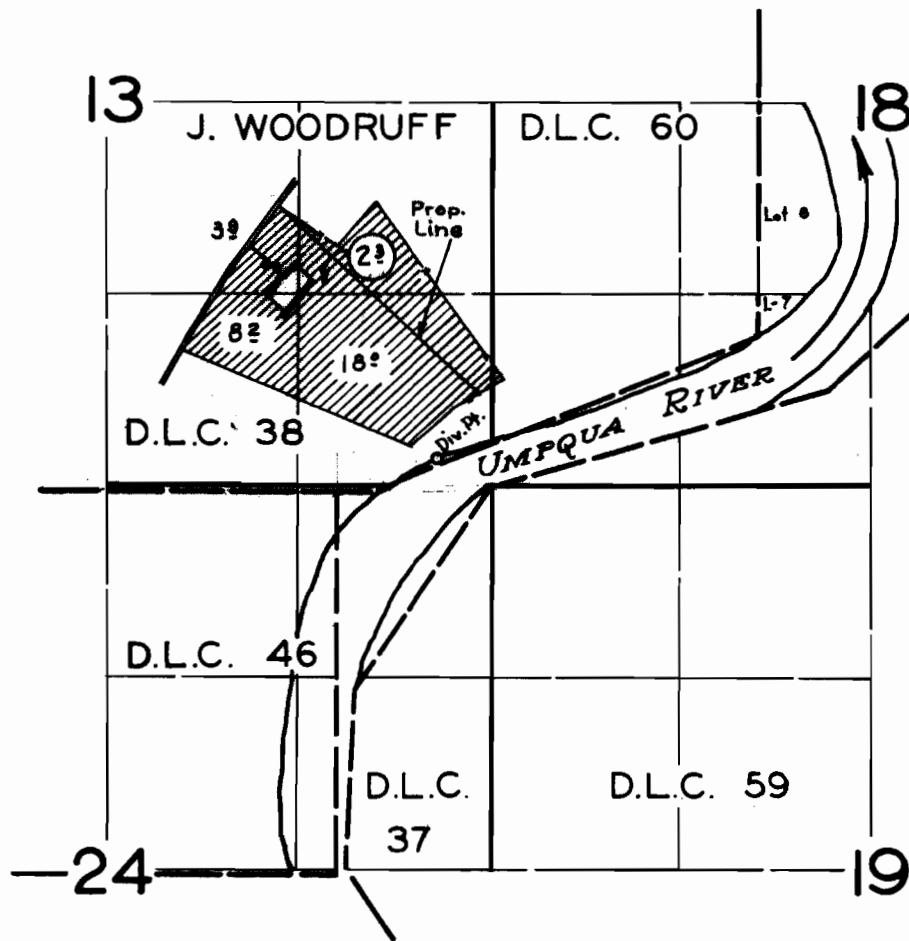

FINAL PROOF SURVEY
UNDER

Application No. 33048. Permit No. 26139...
IN NAME OF

ALBERT L. YOUNG

Surveyed May 2, 1961., by *[Signature]*