


T.29S. R.5W.W.M.

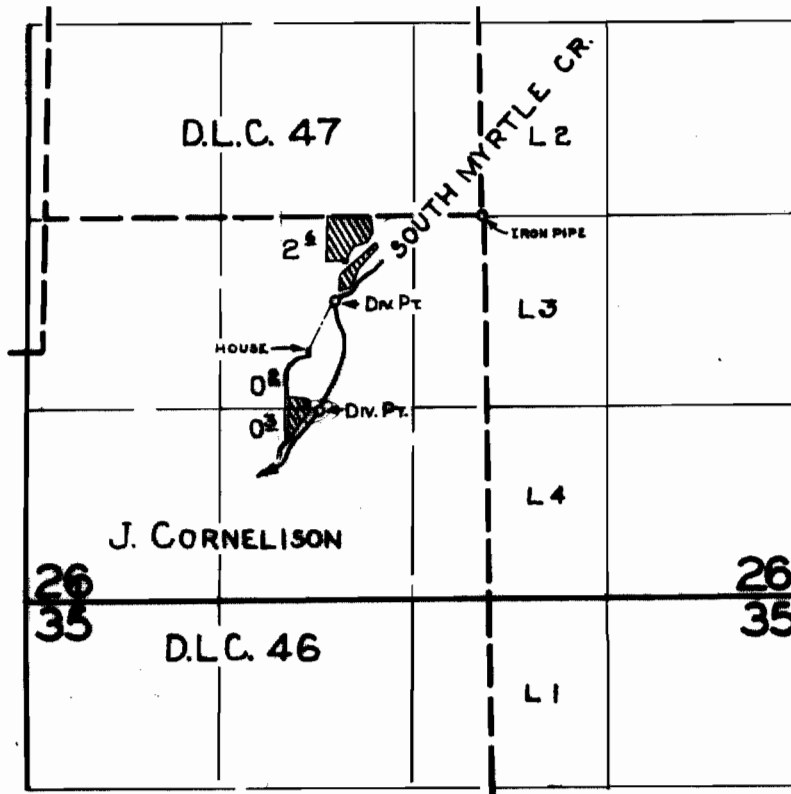

FINAL PROOF SURVEY
UNDER

Application No. 34206 ✓ Permit No. 26948
31753 25043
IN NAME OF

BERTRAM E. & IOLA M. HALL

Surveyed MAY 4 1961, by C.O. BARTELS