


T.36 S. R.2 E.W.M.

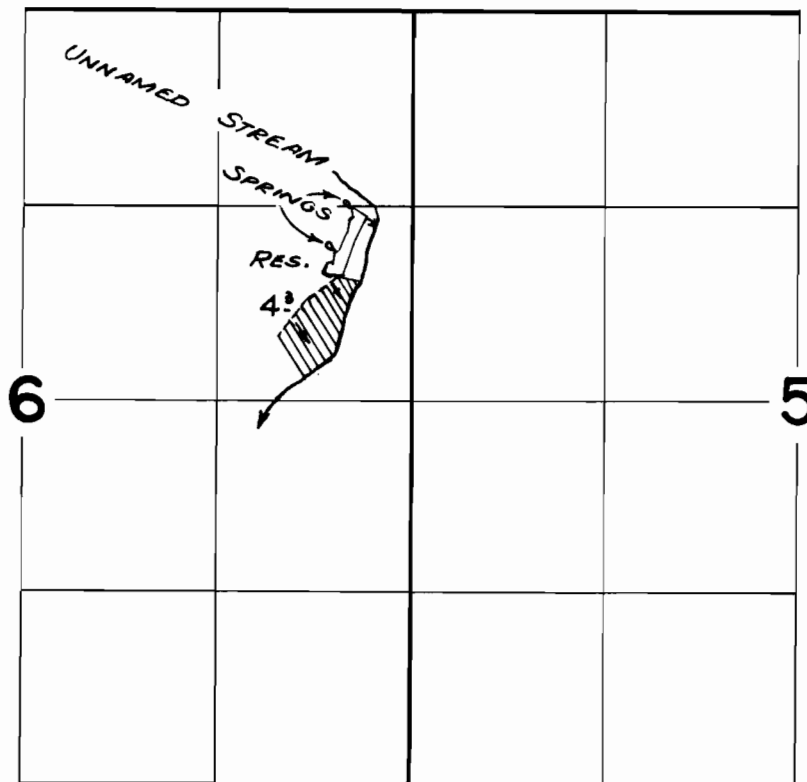

FINAL PROOF SURVEY
UNDER

R-28539 R-1541
Application No. 28540 Permit No. 22507
IN NAME OF

EDMUND & MAXINE PEILE

Surveyed April 12 1961, by W. Jackson