


T.40S. R.3W.W.M.

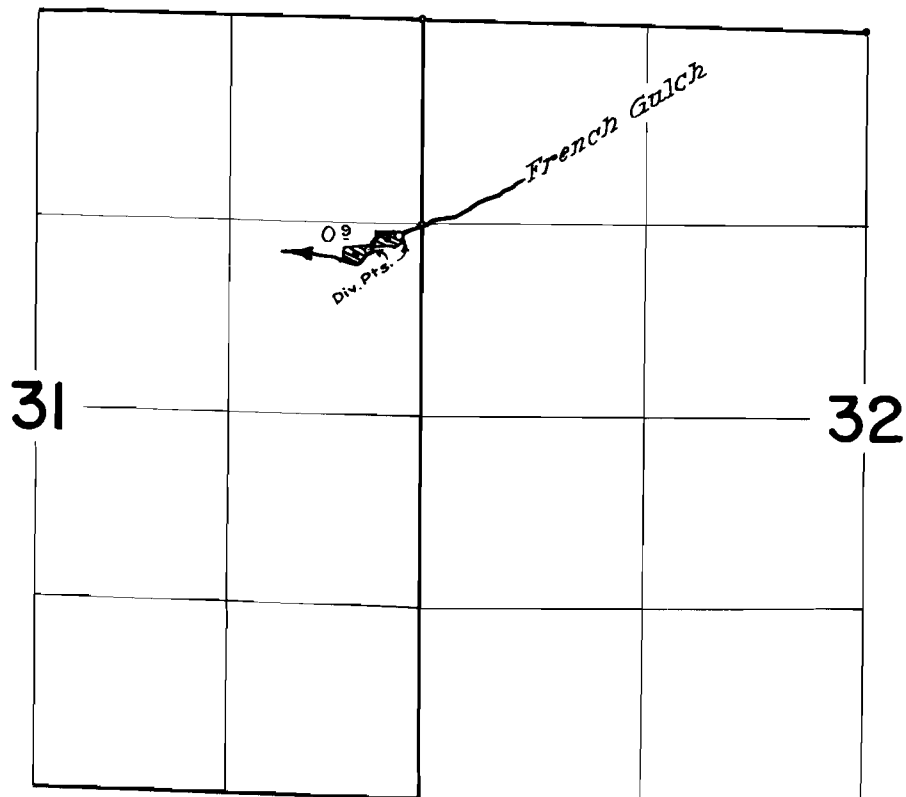

FINAL PROOF SURVEY
UNDER

Application No. 28684 Permit No. 22585
IN NAME OF

BEN F. ALLISON

Surveyed April 20 1961, by

[Handwritten signature]