


T.35 S. R. 4 W. W.M.

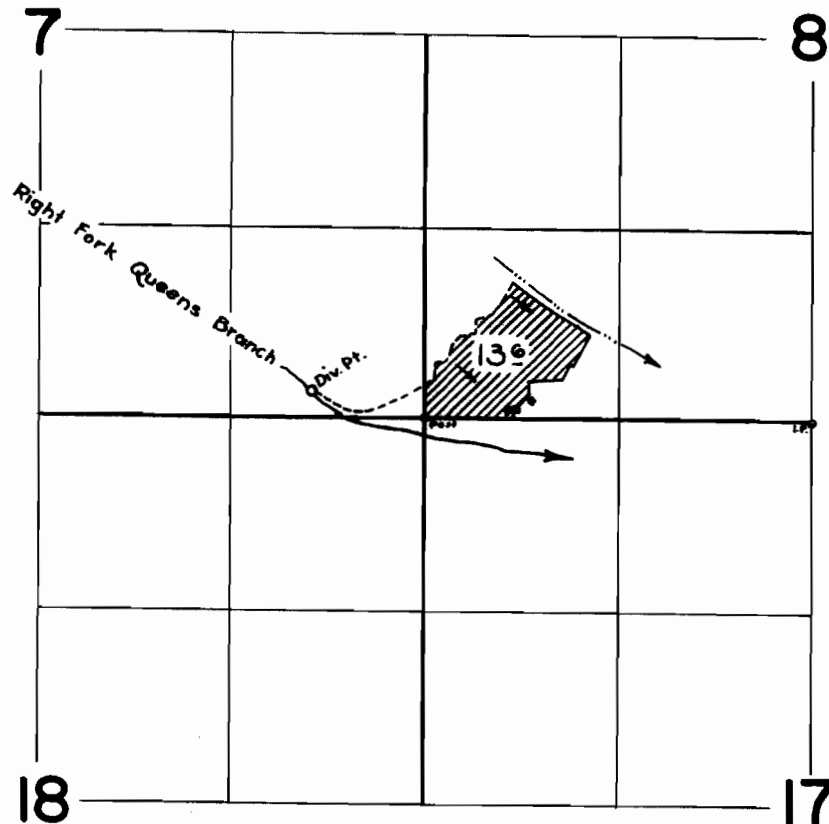

FINAL PROOF SURVEY
UNDER

Application No. 29837 Permit No. 23465
IN NAME OF

JEROME R. BENDER

Surveyed April 17, 1961, by H. Jackson