


T.36S. R. 2-3 W.W.M

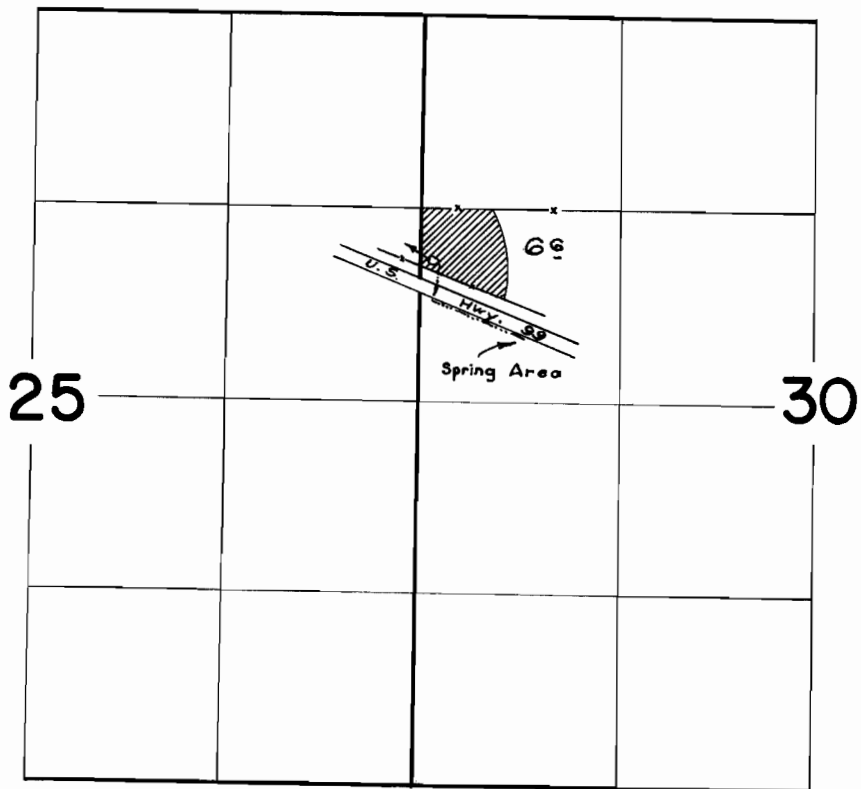

FINAL PROOF SURVEY UNDER

Application No. R-29474 29473 Permit No. R-1730 23488
IN NAME OF

LA. RUE MORRIS

Surveyed April 14, 19....., by *A. Jackson*