


T.36S. R. 2-3 W.W.M

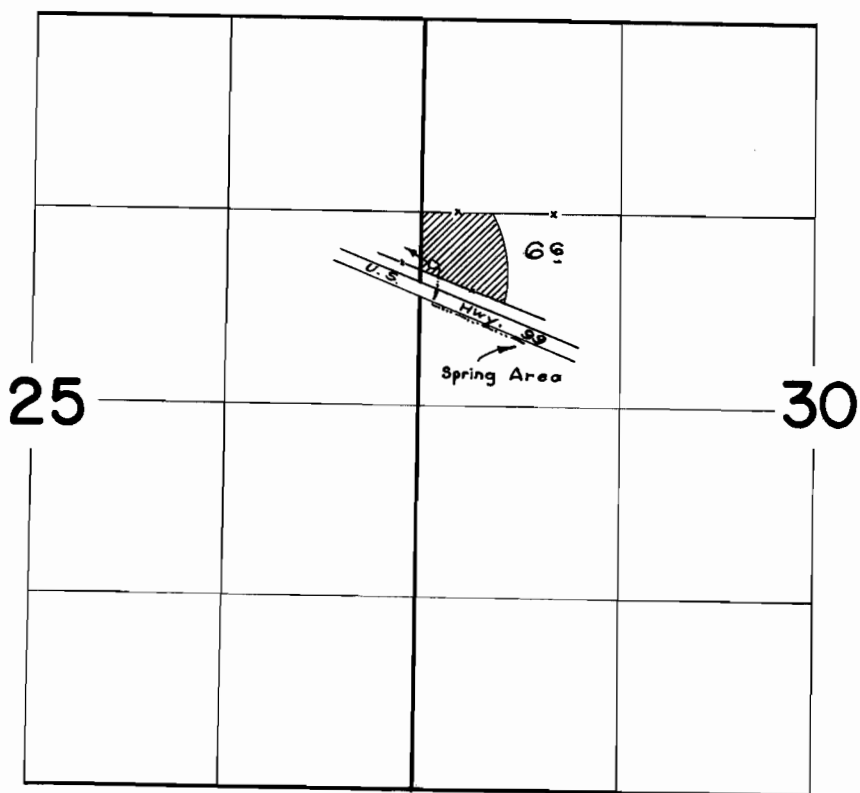

FINAL PROOF SURVEY UNDER

R-29474 R-1730
Application No. 29473 Permit No. 23488
IN NAME OF

LA RUE MORRIS

Surveyed April 14, 19....., by *A. J. Jackson*