


T.35S. R.4 W.W.M.

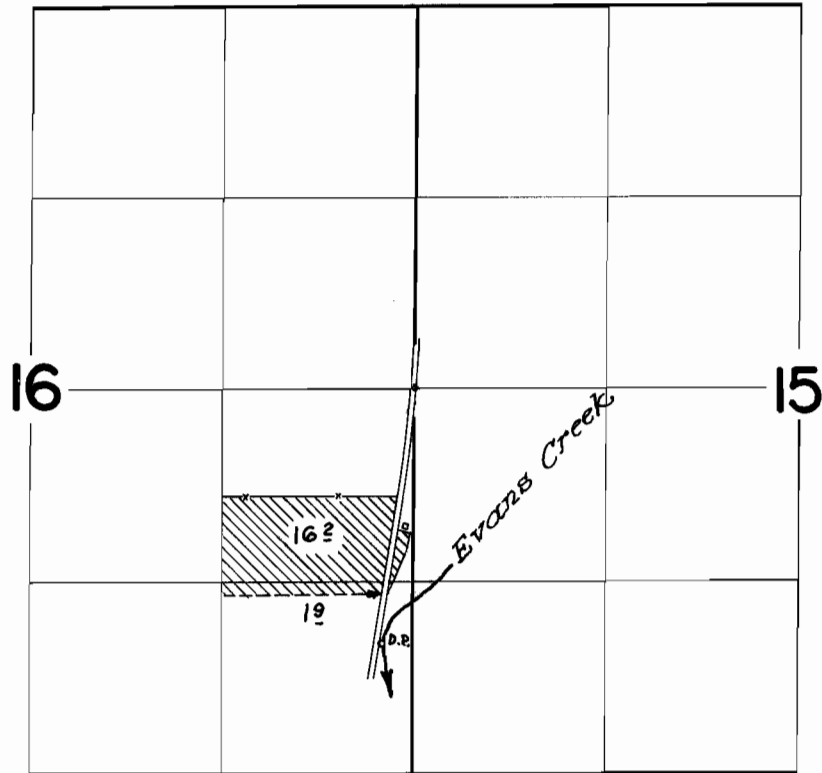

FINAL PROOF SURVEY
UNDER

Application No. 31406... Permit No. 24756..
IN NAME OF

OWEN L. HARDESTY

Surveyed April 14, 1961., by R. H. Johnson