


T.39S.R.7W.W.M.

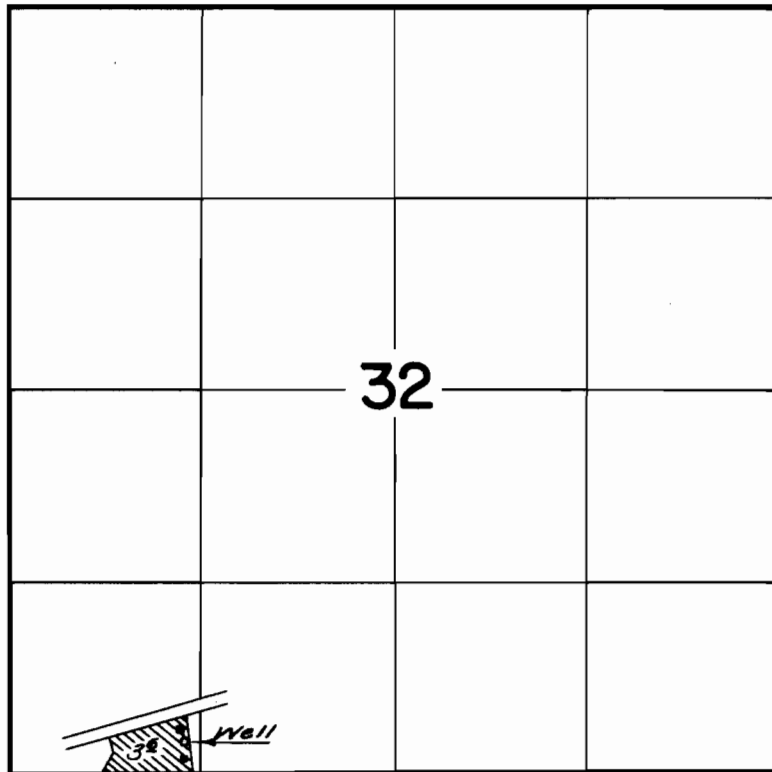

FINAL PROOF SURVEY
UNDER

Application No. *G-924* Permit No. *G-829*
IN NAME OF

.....*S. CURTIS*.....

Surveyed *April 15* 1961., by *cabartolo*