


T. 39S. R. 5W. W.M.

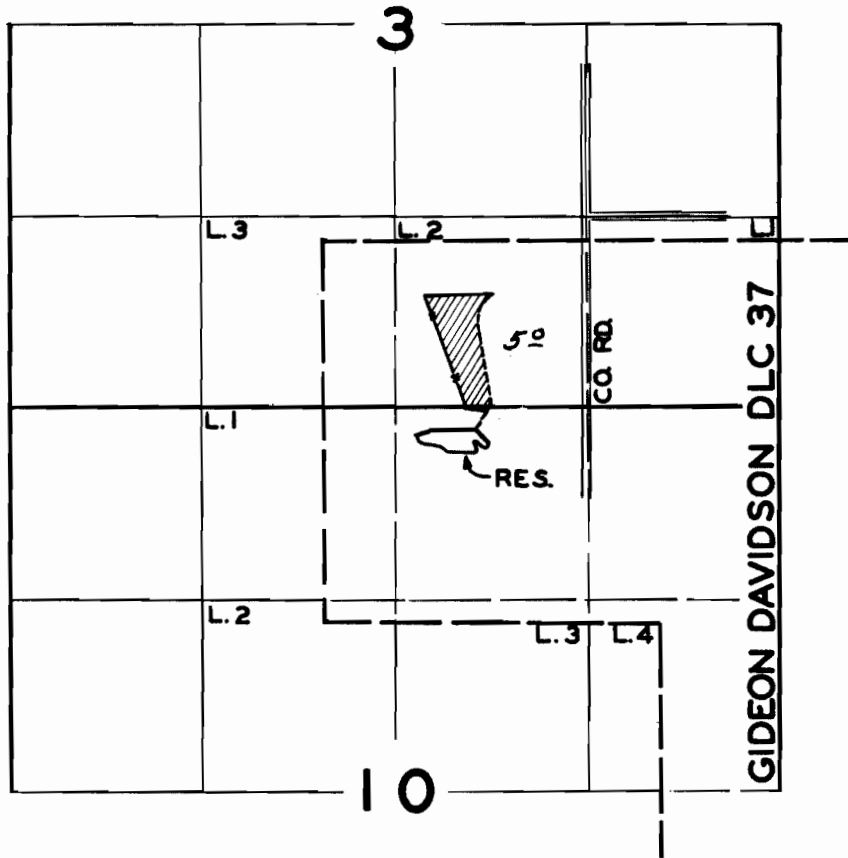

**FINAL PROOF SURVEY**  
UNDER

Application No. <sup>R30119</sup> 30120 Permit No. <sup>R1782</sup> 23772

IN NAME OF

**VIRGIL & KAY BERRY**

Surveyed APRIL 14 1961, by R. D. STEIMER