


TWP 37 S R 7 WWM

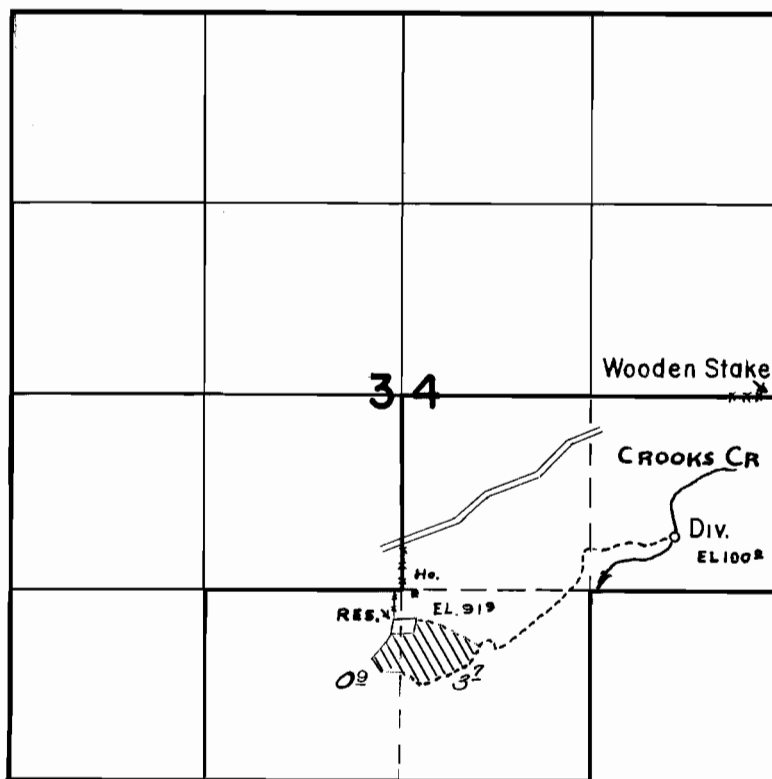

FINAL PROOF SURVEY
UNDER

Application No. 29216 Permit No. 22952
IN NAME OF

Clarence O Wallace

Surveyed 10-17 1961, by STEIMER