


T37S.R.6 W.W.M.

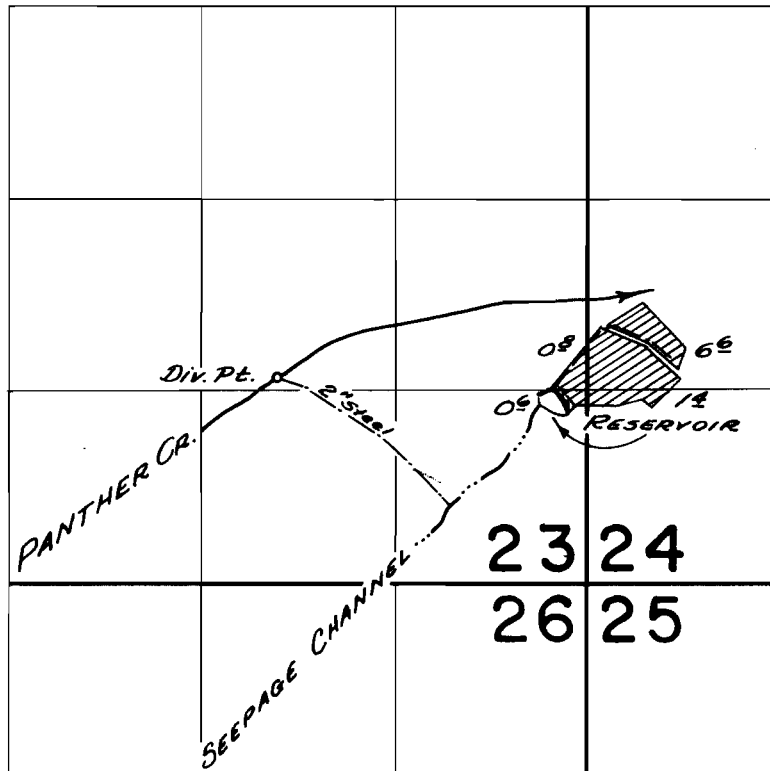

FINAL PROOF SURVEY UNDER

Application No. R-30500 Permit No. R-1827
30501 24019
IN NAME OF

VIVIAN M. REINHARDT

Surveyed APRIL 11 1961, by C. C. Bailla