


T.33S. R.6 W.W.M.

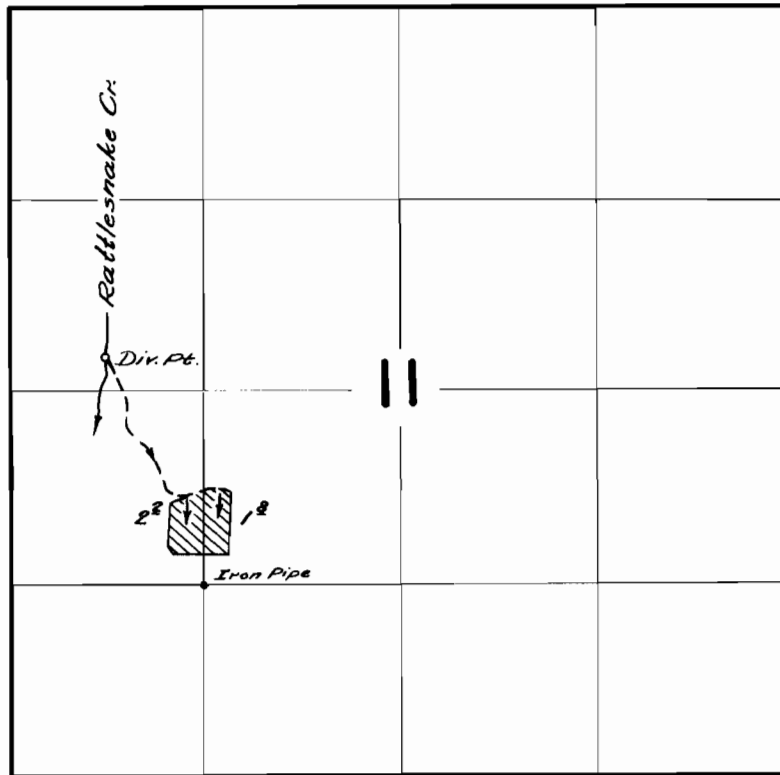

FINAL PROOF SURVEY
UNDER

Application No. 30712 Permit No. 24191
IN NAME OF

WILLIAM HENRY & LAURA MAY KAHL

Surveyed APRIL 12 1961 by C. B. Bartlett