


TWP 39 S R 5 W W M

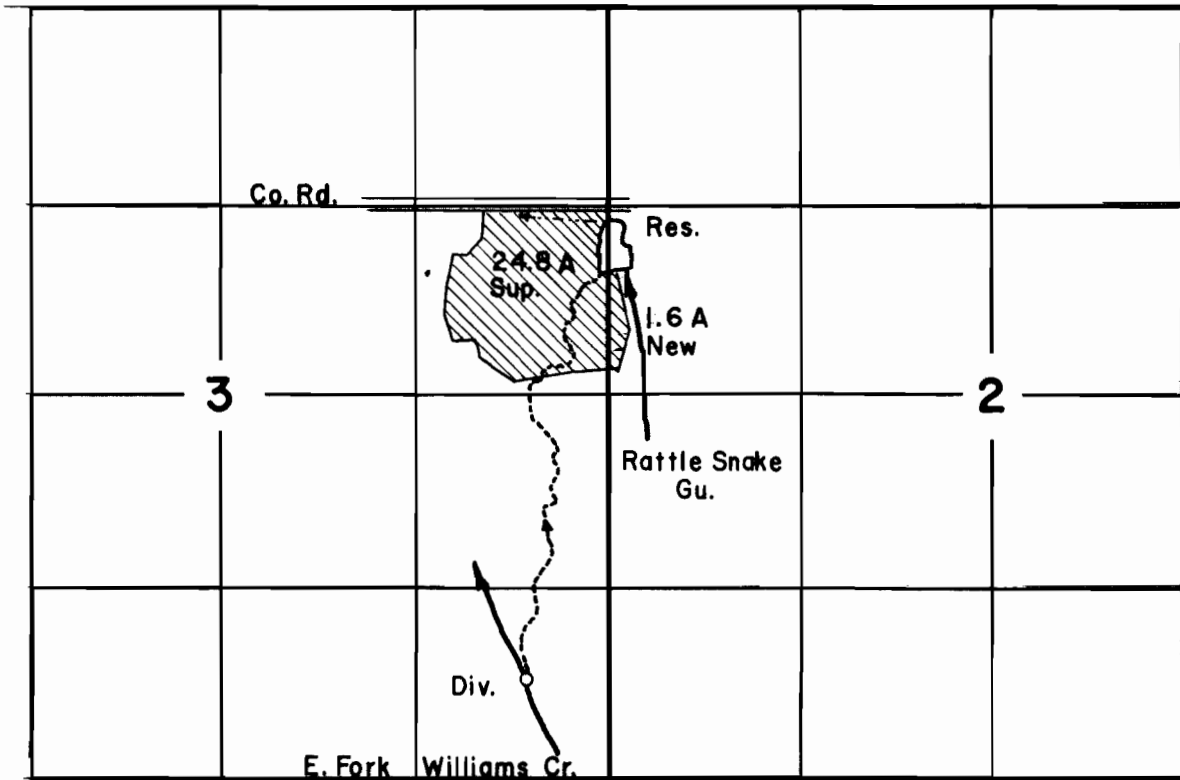

FINAL PROOF SURVEY
UNDER

R-31168 R-1954
Application No. 31169 Permit No. 24564
IN NAME OF

.....Loy & Lena Yokum.....

Surveyed 11-8..... 1961., by Steimer.....